

BENTON MISSISSIPPI BOARD OF WATER COMMISSIONERS


B 2009

10-28-64

WATER WELL DRILLERS LOG

Date: Oct. 28, 1964, Driller: Robert Wilson County Benton
(Name)

(1) Owner of Land: <u>Hubert Hammer</u> <small>(Name)</small>	Description & Color of Materials Sand, Clay, Red Clay, Shell, etc.	Thick- ness Feet	Depth Feet
<u>Grand Junction</u> <small>(Address)</small>	<u>Red clay</u>	<u>10</u>	<u>10</u>
(2) Location: <u>1/4</u> , <u>1/4</u> , Sec. <u> </u> T <u> </u> R <u> </u>	<u>" sand</u>	<u>80</u>	<u>90</u>
<u>6 1/2</u> miles <u>S</u> , of <u>Grand Junction</u> <small>(distance) (direction) (Nearest Town)</small>	<u>white sand</u>	<u>60</u>	<u>150</u>
(3) Topography: <u>X</u> <small>(Hilly) (Flat) (Level)</small>			
(4) Purpose of Well: <u>Domestic</u> <small>(Domestic Irrigation Municipal, Industrial, Other)</small>			
Information upon completion of well:			
(1) Diameter <u>4</u> inches.			
(2) Total Depth <u>150</u> feet.			
(3) Water Level <u>100</u> feet below top of ground.			
(4) Cased to <u>150</u> , Size <u>4</u>			
(5) Screen: Size <u>6"</u> , Length <u>4</u>			
(6) Were any formations sealed against pollution? <u> </u> yes, <u>1</u> no.			
If YES depth of formation _____			
Why _____			
Drillers Remarks: _____			

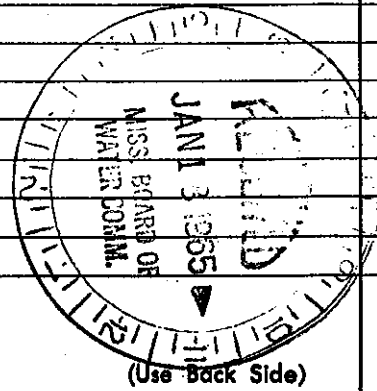

Well No. _____

Mail this copy to Board of Water Commissioners 429 Miss. St. Jackson, Miss.