

**BENTON** MISSISSIPPI BOARD OF WATER COMMISSIONERS

**B** 2010

**6-25-65**


**WATER WELL DRILLERS LOG**

**ROBERT W. WILSON**

Date: 6-25, 1965, Driller: ~~SPENCER~~ County BENTON

(Name)

(1) Owner of Land: <u>UDELL SMITH</u> (Name)	Description & Color of Materials Sand, Clay, Red Clay, Shell, etc.	Thick- ness Feet	Depth Feet
<u>GRAND JCT, TENN</u> (Address)	<u>Red Clay</u>	<u>10</u>	<u>10</u>
(2) Location: <u>1/4</u> , <u>1/4</u> , Sec. <u>   </u> T. <u>   </u> R. <u>   </u>	<u>✓ SAND</u>	<u>75</u>	<u>10-75</u>
<u>6</u> miles <u>SE</u> of <u>GRAND JCT.</u> (distance) (direction) (Nearest Town)	<u>WHITE CLAY</u>	<u>5</u>	<u>75-80</u>
(3) Topography: <u>✓</u> (Hilly) (Flat) (Level)	<u>✓ SAND</u>	<u>45</u>	<u>80-125</u>
(4) Purpose of Well: <u>Domestic</u> (Domestic Irrigation Municipal, Industrial, Other)			
Information upon completion of well:			
(1) Diameter <u>4</u> inches.			
(2) Total Depth <u>125</u> feet.			
(3) Water Level <u>90</u> feet below top of ground.			
(4) Cased to <u>125'</u> , Size <u>4"</u>			
(5) Screen: Size <u>6"</u> , Length <u>4'</u>			
(6) Were any formations sealed against pollution?			
<u>   </u> yes, <u>✓</u> no.			
If YES depth of formation _____			
Why _____			
Drillers Remarks: _____			
_____			
_____			
_____			
_____			

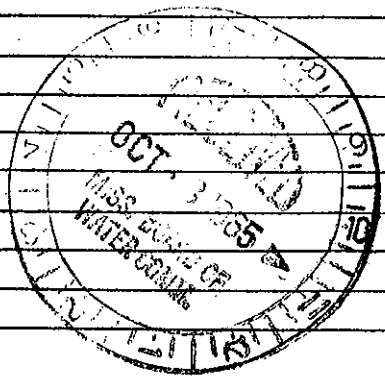

(Use Back Side)

Well No.

Mail this copy to Board of Water Commissioners 429 Miss. St. Jackson, Miss.