

BENTON MISSISSIPPI BOARD OF WATER COMMISSIONERS

B 2011


WATER WELL DRILLERS LOG

10-4-65

Date: 10-4, 1965, Driller: ROBERT W. WILSON County BENTON

(Name)

	Description & Color of Materials Sand, Clay, Red Clay, Shell, etc.	Thick- ness Feet	Depth Feet
(1) Owner of Land: <u>Joe L. Prewitt</u> (Name)	<u>Red clay</u>	<u>10</u>	<u>0-10</u>
<u>GRAND JCT, TENN</u> (Address)	<u>Red sand</u>	<u>10</u>	<u>10-20</u>
(2) Location: <u>1/4</u> , <u>1/4</u> , Sec. <u> </u> T. <u> </u> R. <u> </u>	<u>White clay</u>	<u>10</u>	<u>20-30</u>
<u>6</u> miles <u>S.E.</u> of <u>GRAND JCT.</u> (distance) (direction) (Nearest Town)	<u>Red sand - white clay</u>	<u>30</u>	<u>30-60</u>
(3) Topography: <input checked="" type="checkbox"/> (Hilly) <input type="checkbox"/> (Flat) <input type="checkbox"/> (Level)	<u>White sand, clay</u>	<u>30</u>	<u>60-90</u>
(4) Purpose of Well: <u>Domestic</u> (Domestic Irrigation, Municipal, Industrial, Other)	<u>White sand</u>	<u>10</u>	<u>90-100</u>
Information upon completion of well:			
(1) Diameter <u>4</u> inches.			
(2) Total Depth <u>100</u> feet.			
(3) Water Level <u>60</u> feet below top of ground.			
(4) Cased to <u>100</u> , Size <u>4</u> "			
(5) Screen: Size <u>6</u> " or Length <u>4</u> "			
(6) Were any formations sealed against pollution?			
_____ yes, <input checked="" type="checkbox"/> no.			
If YES depth of formation _____			
Why _____			
Drillers Remarks: _____			

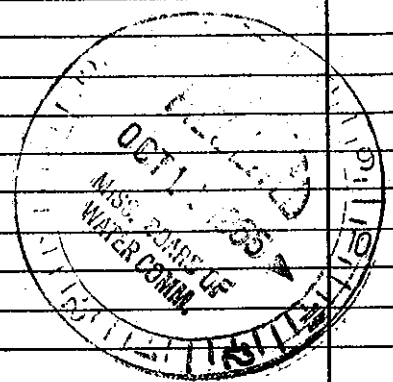

(Use Back Side)

Well No.

Mail this copy to Board of Water Commissioners 429 Miss. St. Jackson, Miss