

Benton
C10
8-67

MISSISSIPPI
BOARD OF WATER COMMISSIONERS
416 North State Street
Jackson, Mississippi 39201

CODED

WATER WELL DRILLERS LOG

Aug. 21 1967 R. L. Carpenter Benton
date well completed firm name county well located

LANDOWNER: Eddie Williams
Grand Junction, RFD
Tenn.
(mailing address)


description of formations encountered	from	to
Surface Soil	0	13
Red clay	13	17
Med. white sand	17	31
fine white clay	31	38
white coarse sand	38	14

WELL LOCATION:
sec. 28 T 1 N R 2 E
3 1/2 miles Northwest of Canaan
(distance) (direction) (nearest town)

WELL PURPOSE: Home
(home, irrigation, municipal, industrial)

- WELL COMPLETION DATA:
- (1) diameter (inches) 4 in.
 - (2) total depth (feet) 142
 - (3) static water level (feet) 120 above top of ground.
 - (4) casing Plastic, 114,
(material) (depth)
(size) If telescope see back.
 - (5) screen 6 ft., 114
(length) (depth to top)
4 in., Plastic + Travel
(size) (material)
 - (6) pump 3/4 12
(HP) (yield gpm)
Elec.
(type power)
 - (7) electric log no
(yes or no)
(organization running log)
 - (8) how well bottom plugged Plastic Plug

CODED

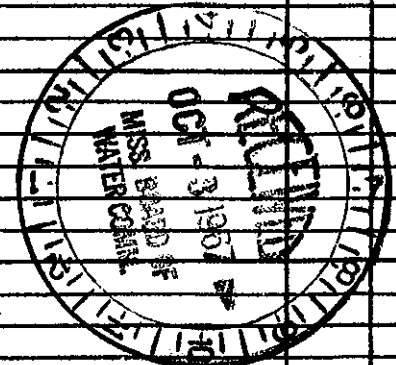

DRILLERS REMARKS: