

Benton
 C 15
 9-14-73

MISSISSIPPI
 BOARD OF WATER COMMISSIONERS CODED
 416 North State Street
 Jackson, Mississippi 39201
 WATER WELL DRILLERS LOG

Sept 14 1973 Robert W. Wilcox Benton
 date well completed firm name county well located

LANDOWNER Frank Hines
 Daulsbury, In.
 (mailing address)


WELL LOCATION:
 sec. 23 T 1 N R 2 E
 (S) (W)
 (distance) miles (direction) of (nearest town)

WELL PURPOSE:
 (home, irrigation, municipal, industrial)

- WELL COMPLETION DATA:
- (1) diameter (inches) 4
 - (2) total depth (feet) 168
 - (3) static water level (feet) 136 below above top of ground.
 - (4) casing (material) 156 (depth)
 (size) If telescope see back.
 - (5) screen 12 156
 (length) (depth to top)
 4 gravel packed
 (size) (material)
 - (6) pump (HP) (yield gpm)
 electric (type power)
 - (7) electric log (yes or no)
 (organization running log)
 - (8) how well bottom plugged 4"
 plastic cap

description of formations encountered	from	to
red clay, red sand	0	30
red sand	30	60
red sand white clay	60	90
white clay red sand	90	105
white clay	105	135
white clay white sand	135	152
white sand	152	170

CODED

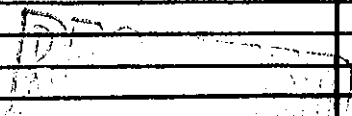

FEB 19 1974

DRILLERS REMARKS:

MISS. BD. OF WATER COMM