

State Well Report

Part 1 - Driller's Log

Mississippi Department of Environmental Quality
Office of Land and Water Resources
P.O. Box 10631
Jackson, MS 39289-0631
(601)961-5210
(601)354-6938 (fax)

For Office Use Only:

Aquifer: _____
Well #: C-31
L. S. Elevation: _____
E-log #: _____

County: Benton
Permit #: _____
Driller: Wilson Wew - John Cox
Date drilling completed: 2-21-07

State Law requires that this report be prepared by the license holder responsible for the work and filed with the Department at the above address within 30 days of completion of drilling of the well or borehole.


Information on Well Owner (Landowner if borehole is not for a water well)	Well or Borehole Location
Owner Name: <u>ENVOYOR GROUP - JOHN LIND LOREN</u>	Latitude: _____ Longitude: _____
Mailing Address: <u>Rt 1 Box TN 42J</u>	Method of Lat/Long (circle one): Conventional Survey, USGS quad, Hand-held GPS, Survey-grade GPS
<u>ASHLAND</u> <u>Ms</u> <u>38603</u> City State Zip Code	_____ 1/4 _____ 1/4 Sec <u>32</u> Twn <u>T15</u> Rng <u>R2E</u>
Telephone No. <u>(662) 223-0382</u>	Distance <u>5</u> Miles Direction <u>E</u> of Nearest Town <u>NW 7</u>
Well / Borehole Data	
Date drilling started: <u>2-21-07</u> Date drilling completed: <u>2-21-07</u> Hole depth: <u>130</u> Hole diameter: <u>4"</u>	
Location of the source of any surface water used for drilling: <u>PUBLIC SUPPLY</u>	
Method of dosing and volume of Chlorine used in drilling and development: <u>50 PPM - DIRECT</u>	
Logs run (circle all applicable): <u>No log run</u> Electric Gamma Ray Density Sonic Neutron Other: _____	
Name of organization running log(s): _____	
Purpose of borehole (check one): Water Well <input checked="" type="checkbox"/> Geotechnical/Geological Investigation _____ Ground Source Heat Pump _____	
Seismic Survey _____ Other (describe) _____	
<i>If drilling is not related to water well construction, skip the remainder of this block</i>	
Purpose of Well (check one): Home <input checked="" type="checkbox"/> Industrial _____ Public Supply _____ Irrigation _____ Fish Culture _____ Other: _____	
If a flowing well, method of flow regulation: Valve _____ Other (describe) _____	
Static Water Level: <u>86</u> feet above or below (circle one) land surface Date measured: <u>2-21-07</u>	
Method of Measurement (circle one) steel tape electric tape air line other: <u>PVC Pipe</u>	
Well depth: <u>130</u> Well grouted to a depth of <u>10</u> feet Type of grout (circle one): Neat Cement <u>Bentonite</u> Mix	
Casing length: <u>130</u> feet Casing diameter: <u>4</u> inches Type of casing: <u>PLASTIC PVC</u>	
Screen length: <u>10</u> feet Screen diameter: <u>4</u> inches Type of screen: <u>PLASTIC PVC</u>	
Screen slot size: <u>.010</u> inches Setting depth: From <u>120</u> feet to <u>130</u> feet	
Type of completion (circle all applicable): <u>Gravel packed</u> Underreamed Telescoped Open hole Natural Development	
Other (describe): _____	
Top of lap pipe or reduction in casing: <u>NA</u> feet. <i>If telescoped or more than one screen, describe on next page</i>	

RECEIVED
MAR 07 2007
BY: OLWR

The sketch below only required for water wells

If well telescopes, show depths on sketch.

Ground Level 

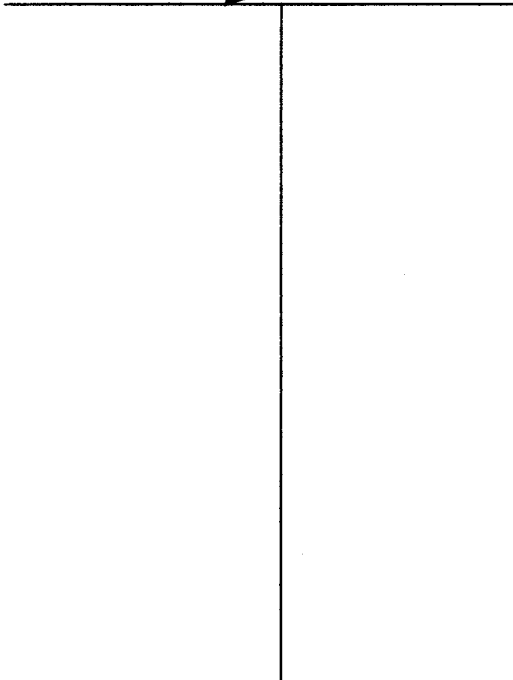


Description of formations encountered must be provided for all wells and boreholes, unless specifically exempted by regulations

Description of Formations Encountered	From (depth)	To (depth)
Red CLAY	Ground Level	15
SAND	15	30
SAND	30	45
SAND	45	60
SAND	60	75
SAND / CLAY	75	90
SAND	90	105
SAND	105	130



If more than one screen, show location of each on sketch

Sketch the property layout and include the following: 1) the well location; 2) any permanent structures on the property that may aid in locating the well; 3) any roads, power lines, or other items that may aid in locating the property and the well; 4) a north arrow.

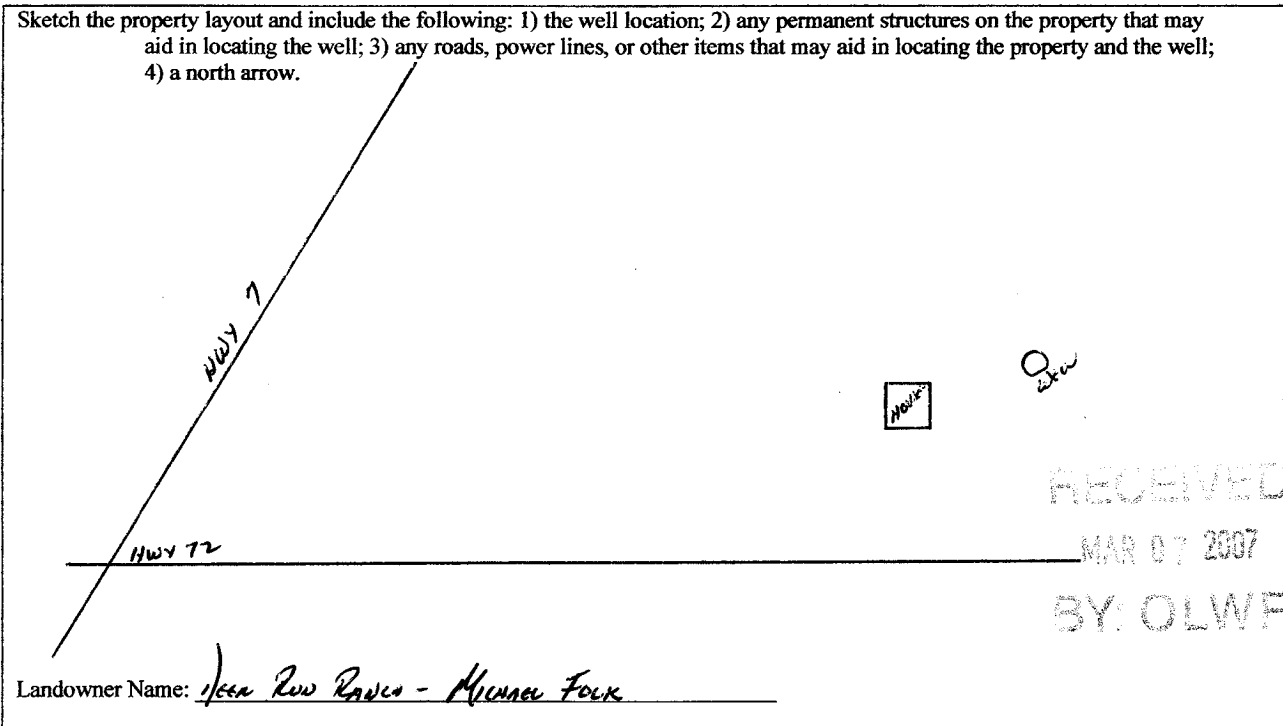

Form: OLWR-SWR-1A

I certify that the well/borehole was drilled, constructed, and completed in accordance with all applicable requirements of the Mississippi Department of Environmental Quality and the Mississippi Department of Health regulations, if applicable, and state laws.

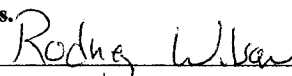Print Name of Responsible Licensee and License No. Date Signature of Licensee

STATE WELL REPORT

Part 2

Pump Installer's Completion Report
 Mississippi Department of Environmental Quality
 Office of Land and Water Resources
 P.O. Box 10631
 Jackson, MS 39289-0631
 (601)961-5210
 (601)354-6938 (fax)

County: Benton
 Permit #: _____
 Driller: Wilson Weir - Tom Cox
 Date completed: 2-21-07
Copy information from block on Part 1

For Office Use Only:

Aquifer: _____
 Well #: C-31
 Elevation: _____

This part of the report must be completed by a licensed water well contractor or a licensed pump installer. A copy of Part 1 of the report must be attached and both parts filed with the Department at the above address within 30 days of well completion.

Well Owner Information	Well Location
Owner Name: <u>EMMAVON GARDNER - JERRY RAY GARDNER</u>	Latitude: _____ Longitude: _____
Mailing Address: <u>RT1 Box TN 425</u>	Method of Lat/Long (check one): Conventional Survey _____, USGS quad _____, Hand-held GPS _____, Survey-grade GPS _____
<u>Ashtown</u> <u>MS</u> <u>38603</u> City State Zip Code	_____ ¼ _____ ¼ Sec <u>32</u> T <u>T1S</u> R <u>R2E</u>
Telephone No. <u>(662) 223-0382</u>	Distance Direction Nearest Town <u>5</u> Miles <u>E</u> of <u>HWY 7</u>

Pump Type Circle one	Power Type Circle one
Air Lift Jet <input type="radio"/> <u>Submersible</u> <input checked="" type="radio"/>	Diesel Engine Gasoline Engine Natural Gas
Bucket Piston <input type="radio"/> Turbine <input type="radio"/>	<u>Electric Motor</u> <input checked="" type="radio"/> Hand Tractor PTO
Centrifugal Rotary <input type="radio"/> Flowing Well <input type="radio"/>	Windmill Other (specify): _____
Other (specify): _____	Horse Power Rating of Motor: <u>3/4</u>
Date Pump Installed: <u>2-21-07</u>	Setting Depth: <u>100</u> feet
Rated Pump Capacity: <u>14</u> Gallons Per Minute	Number of Stages: <u>12</u>

RECEIVED
 MAR 07 2007
 BY: OLWR

Pump Test Data	Method of Measuring Water Level Circle one
Date Well Tested: <u>2-21-07</u>	Air Line Electric Measuring Line Steel Tape
Static Water Level (A): <u>80</u> Feet Below Land Surface	Other (specify): <u>AC PLASTIC PIPE</u>
Pumping Water Level (B): <u>180</u> Feet Below Land Surface	For flowing well, measured shut in head: _____ feet
Drawdown [(B) - (A)]: <u>20</u> Feet Below Land Surface	Well yielded _____ GPM with a drawdown of _____ feet after _____ hours of pumping
Test Pumping Rate: <u>14</u> Gallons Per Minute	
Duration of Pump Test (minimum 4 hours): _____ hours	

I HEREBY CERTIFY that the above statements are true to the best of my knowledge.

Rodney O. Wilson 0-418 _____
 Print Name of Pump Installer and License No. (if applicable) Signature of Pump Installer