

BENTON

MISSISSIPPI BOARD OF WATER COMMISSIONERS

6300

C 3A

11-8-60

WATER WELL DRILLERS LOG

Date: Nov. 8, 1960, Driller: Robert W. Wilson, County: Benton

(Name)

(1) Owner of Land: Curtis Hines
Hopewell, Miss.
(Address)
(2) Location: 2 North, Hopewell T R
miles. of (Nearest Town)
(distance) (direction) (Level)
(3) Topography: Home (Level)
(4) Purpose of Well:
(Domestic Irrigation
Municipal, Industrial, Other)

Description & Color of Materials Sand, Clay, Red Clay, Shell, etc.	Thick- ness feet	Depth feet
Red Sand	7'	0'
White Sand	124'	96'-1

Information upon completion of well:

(1) Diameter 4 inches.

(2) Total Depth 124 feet.

(3) Water Level 124 feet below top of ground. 4"

(4) Cased to 4", Size 6'


(5) Screen: Size _____, Length _____

(6) Were any formations sealed against pollution?
X yes, _____ no.

If YES depth of formation _____

Why _____

Drillers Remarks: _____

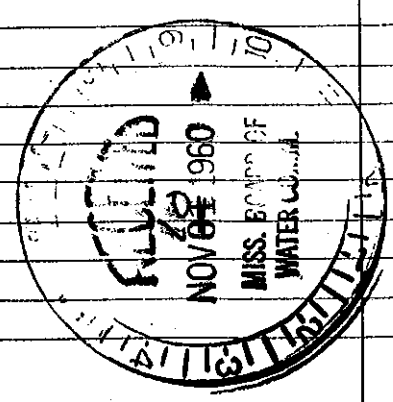

(Use Back Side)

Well No.