

BENTON

MISSISSIPPI BOARD OF WATER COMMISSIONERS

C 2000

9-19-61 WATER WELL DRILLERS LOG

Date: 9-19-61, Driller: Robert W. Wilson, Benton County

(Name)

(1) Owner of Land:	Description & Color of Materials Sand, Clay, Red Clay, Shell, etc.	Thick- ness Feet	Depth Feet
Carl Todd Memphis, Tenn. (Name) (Address)	1/2 Blue Clay, Red Clay, Shell 1/2 Blue Sand Blue Sand	7 10	0-69 61-79
(2) Location: 1/4, 1/4, Sec. T R 15 N-E Ashland miles of Hill (Nearest Town) (distance) (direction)			
(3) Topography: (Hilly) (Flat) (Level) None			
(4) Purpose of Well: (Domestic Irrigation Municipal, Industrial, Other)			


Information upon completion of well:

- (1) Diameter 4 inches.
- (2) Total Depth 79 feet.
- (3) Water Level 30 feet below top of ground.
- (4) Cased to 79, Size 4"
- (5) Screen: Size 4", Length 6'
- (6) Were any formations sealed against pollution?
X
yes, no.

If YES depth of formation

Why

Drillers Remarks:

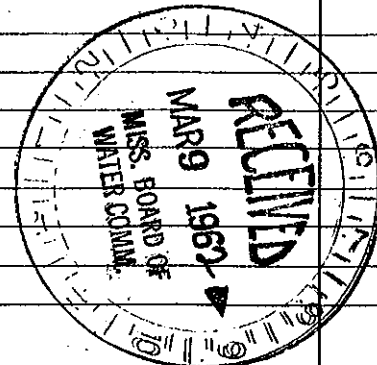

(Use Back Side)

Well No.

Mail this copy to Board of Water Commissioners 429 Miss. St. Jackson, Miss.