

BENTON  
C 2034

MISSISSIPPI DEPARTMENT OF NATURAL RESOURCES  
Bureau of Land and Water Resources  
Southport Mall  
P.O. Box 10631  
Jackson, Mississippi 39209  
WATER WELL DRILLERS LOG

3-11 1997 Mellen Well Benton  
date well completed firm name county well located

LANDOWNER: Jim Kidd  
(mailing address)

WELL LOCATION:  
sec. 34 T 1 N R 2 E  
5 miles NE of Ashland  
(distance) (direction) (nearest town)


WELL PURPOSE: Home  
(home, irrigation, municipal, industrial)

WELL COMPLETION DATA:

(1) diameter (inches) 4"  
(2) total depth (feet) 620'  
(3) static water level (feet) 160' (below above top of ground.)  
(4) casing 4" PVC, 340' (material) (depth)  
4" Sch 40 (size) If telescope see back.  
(5) screen 60ft, 540ft (length) (depth to top)  
2" Sch 40 PVC (size) (material)  
(6) pump 1/2hp, 12gpm (HP) (yield gpm)  
220 VAC (type power)  
(7) electric log (yes or no)  
(organization running log)  
(8) how well bottom plugged 2" sch 40 pvc cap

description of formations encountered	from	to
Top Soil	0	60
White Clay + Clay Mix	60	120
Agassiz + Mineral Water (Iron)	120	190
Clay + Shell Rock + Limestone Mix	190	400
Limestone	400	520
Mass Agassiz (Bartesian)	520	620

Telescoped:  
260' of 2" casing  
from bottom to  
330' from bottom

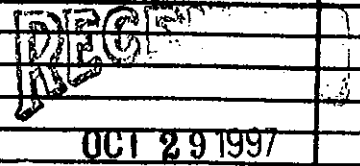

DRILLERS REMARKS: Dept. of Environment & Natural Resources  
Office of Land & Water Resources