

Benton  
 D25  
 2-67

MISSISSIPPI  
 BOARD OF WATER COMMISSIONERS  
 416 North State Street  
 Jackson, Mississippi 39201  
 WATER WELL DRILLERS LOG

**CODED**

Feb 13 1967 Thorpe Well Supply Benton  
 date well completed firm name county well located


LANDOWNER: Carl O. Morgan  
 Holly Springs Miss  
 (mailing address)

description of formations encountered	from	to
Top Soil	0	10
Brown Sand	10	65
White Clay + Sand mixed	65	85
White coarse sand	85	105
White fine sand	105	125
White coarse sand	125	150

WELL LOCATION:  
 sec. 17 T-2 N R-1 E  
 1 miles WEST of LAMAR  
 (distance) (direction) (nearest town)

WELL PURPOSE: Home  
 (home, irrigation, municipal, industrial)

- WELL COMPLETION DATA:
- (1) diameter (inches) 4"
  - (2) total depth (feet) 150
  - (3) static water level (feet) 100 <sup>below</sup> top of ground.
  - (4) casing PVC, 150 (material) (depth)  
 4" (size) If telescope see back.
  - (5) screen 4' 146 (length) (depth to top)  
 4" PVC + SAND (size) (material)
  - (6) pump 3/4 16 (HP) (yield gpm)  
 230 (type power)
  - (7) electric log NO (yes or no)
  - (8) how well bottom plugged 4" CAP

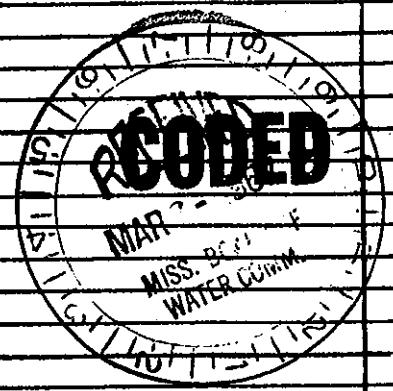

DRILLERS REMARKS: