

Benton
D26
3-67

MISSISSIPPI
 BOARD OF WATER COMMISSIONERS
 416 North State Street
 Jackson, Mississippi 39201

CODED

WATER WELL DRILLERS LOG

2-22 19*67* *Robert Wilson* *Benton*
 date well completed firm name county well located

LANDOWNER: *United Community*
action committee
Hubbard Miss. (Coahoma)
 (mailing address)


description of formations encountered	from	to
<i>Red clay</i>	<i>0</i>	<i>10</i>
<i>Red sand</i>	<i>10</i>	<i>130</i>
<i>White clay white sand</i>	<i>130</i>	<i>150</i>
<i>White sand</i>	<i>150</i>	<i>180</i>

WELL LOCATION:
 sec. *27* T. *2* N. R. *1* E.
4 miles *SE* of *Jarvis*
 (distance) (direction) (nearest town)

WELL PURPOSE:
 (home, irrigation, municipal, industrial)

WELL COMPLETION DATA:
 (1) diameter (inches) *4"*
 (2) total depth (feet) *180'*
 (3) static water level (feet) *150'* below above top of ground.
 (4) casing *plastic* *176'*
 (material) (depth)
4 if telescope see back.
 (size)
 (5) screen *4"* *176'*
 (length) (depth to top)
4 *Gravel pack*
 (size) (material)
 (6) pump *3/4* *18*
 (HP) (yield gpm)
Elect.
 (type power)
 (7) electric log (yes or no)
 (organization running log)
 (8) how well bottom plugged *4"*
plastic cap

CODED

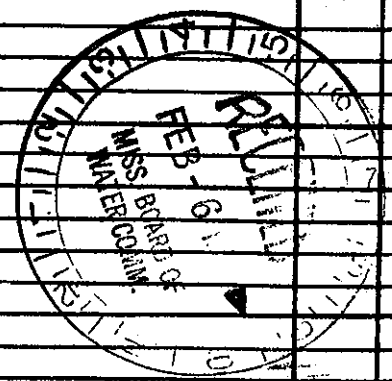

DRILLERS REMARKS: