State Well Report					
_		For Office Use Only:			
County: Benton	Part 1 – Driller's Log	For Onice Use Only:			
	Mississippi Department of Environmental Quality	Aquifer:			
Permit #:	Office of Land and Water Resources	well #: D-63			
Driller: Jones W. Magun	P.O. Box 10631				
	Jackson, MS 39289-0631	L. S. Elevation:			
Date drilling completed: 6. 31-06	(601)961-5210				
	(601)354-6938 (fax)	E-log #:			

 State Law requires that this report be prepared by the license holder responsible for the work and filed with the

 Department at the above address within 30 days of completion of drilling of the well or borehole.

 Information on Well Owner
 Well or Borehole Location

Information on Well Owner	Well or Borehole Location			
(Landowner if borehole is not for a water well)	Real and the second of the second second			
Owner Name Woody Smith.	Latitude: $34 \cdot 55$ , 107, "Longitude: $89 \cdot 30$ , 676," Method of Lat/Long (circle one): Conventional Survey,			
Mailing Address: 1387 Allen Cros. rd.	USGS quad, (Hand-held GP3, Survey-grade GPS			
City State Zip Code	NE1/ SW1/ Sec 7 Twn JS Rng W			
City State Zip Code	Distance Direction Nearest Town			
Telephone No. (401) 647-5534	<u>I'ly Miles NW of Lammar</u>			
Well / Bore	Length Contraction Contractio			
Date drilling started: $6 - 31 - 06$ Date drilling completed: $6 - 31 - 06$ Hole depth: $135^{\circ}$ Hole diameter: $63/4^{\circ\prime\prime}$				
Location of the source of any surface water used for drilling:				
Method of dosing and volume of Chlorine used in drilling and devel	lopment:			
Logs run (circle all applicable): No log run Electric Gamma Ray Density Sonic Neutron Other: Name of organization running log(s):				
Purpose of borehole (check one): Water WellGeotechnical/Geological Investigation Ground Source Heat Pump				
Seismic Survey Other ( <i>describe</i>	2)			
If drilling is not related to water well construction	on, skip the remainder of this block			
Purpose of Well (check one): Home // Industrial Public Supply Irrigation Fish Culture Other:				
If a flowing well, method of flow regulation: Valve Other (describe)				
Static Water Level: 110 <sup>1</sup> feet above or below (circle one) land surface Date measured: <u>6-31-06</u>				
Method of Measurement (circle one) steel tape electric tape air line other: String weight.				
Well depth: 185 Well grouted to a depth of 10 feet Type of grout (circle one): Neat Cement Bentonite Mix				
Casing length: 175 feet Casing diameter: 4 inches Type of casing: put				
Screen length: <u>10</u> feet Screen diameter: <u>4</u> inches Type of screen: <u>pu</u>				
Screen slot size: inches Setting depth: From feet to feet				
Type of completion (circle all applicable): Gravel packed Underreamed Telescoped Open hole Natural Development				
Other (describe):				
Top of lap pipe or reduction in casing:feet. If telescoped or more than one screen, describe on next page				

Form: OLWR-SWR-1A


## The sketch below only required for water wells

If well telescopes, show depth	is on sketch.
Ground Level	

## Description of formations encountered must be provided for all wells and boreholes, unless specifically exempted by regulations

Description of Formations Encountered	From (depth)	
clay dert.	Ground Level	30
I col Soud	30	60
white soud	60	100
while clay	100	120
white soud	120	185
•		
	-	

If more than one screen, show location of each on sketch

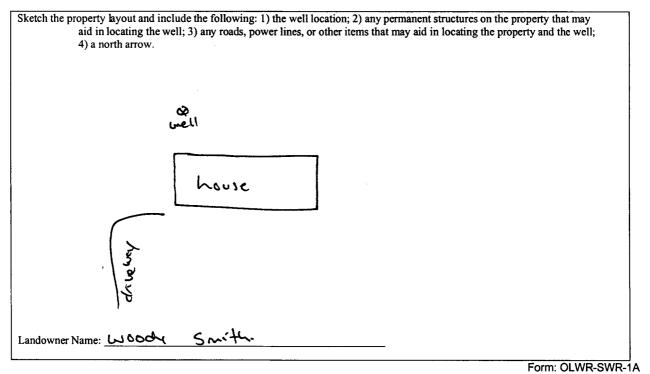

I certify that the well/borehole was drilled, constructed, and completed in accordance with all applicable requirements of the Mississippi Department of Environmental Quality and the Mississippi Department of Health regulations, if applicable, and state laws.

7-19-06

Date

Jones W. Moson. 0-620

Signature of Licensee

Print Name of Responsible Licensee and License No.

STATE WELL REPORT				
County:       Derror         Permit #:       Pump Installer's         Driller:       Jones wMessor         Date completed:       G-21-06         (601)	art 2       For Office Use Only:         accompletion Report       Aquifer:         accompletion Report       Aquifer:         accompletion Report       Market Resources         Box 10631       Market Resources         Box 10632       Market Resources         Box 10633			
Owner Name: WOOdy Snith Mailing Address: 1387 Allen crn. rd, Lammer MS 38647 City State Zip Code Telephone No. (90) 647-5524	Latitude: $34.55.107$ Longitude: $89.20.6\%$ Method of Lat/Long (check one): Conventional Survey, USGS quad, Hand-held GPS, Survey-grade GPS $NE \frac{1}{50} \frac{1}{4} \frac{50}{14} \frac{1}{500} \frac{1}{14} \frac{1}{500} \frac{1}{14} \frac{1}{500} \frac{1}{14} \frac{1}{500} \frac{1}{14} \frac{1}{500} \frac{1}{500}$			
Pump Type Circle one         Air Lift       Jet       Submersible         Bucket       Piston       Turbine         Centrifugal       Rotary       Flowing Well         Other (specify):	Power Type Circle one         Diesel Engine       Gasoline Engine       Natural Gas         Electric Motor       Hand       Tractor PTO         Windmill       Other (specify):			
Pump Test Data         Date Well Tested: $6 - 31 - 06$ Static Water Level (A): $100$ Feet Below Land Surface         Pumping Water Level (B): $NA$ Feet Below Land Surface         Drawdown [(B) - (A)]: $NA$ Feet Below Land Surface         Test Pumping Rate: $12$ Gallons Per Minute         Duration of Pump Test (minimum 4 hours): $34$ hours	Method of Measuring Water Level Circle one         Air Line       Electric Measuring Line       Steel Tape         Other (specify):			
I HEREBY CERTIFY that the above statements are true to the best of my knowledge. <u>Jones</u> <u>W. Mojan</u> . Print Name of Pump Installer and License No. (if applicable) Signature of Pump Installer				

÷ 1

.

•

Signature of Pump Installer

Form: OLWR-SWR-1B