	State W	/ell Renort			
20 - to 11 30 tous	State Well Report Part 1 – Driller's Log		For Office Use Only:		
County: Anton Benton.	Mississippi Department of Environmental Quality		Aquifer:		
Permit #:		nd Water Resources	Aquifer:		
Driller: Jones W. Mason	P.O. Box 2309 Jackson, MS 39225		•		
Date drilling completed: 10-34-08		961- 5210 1 5228 (fax)	L. S. Elevation:		
	(601)96	1- 5228 (fax)	E-log #:		
	State Law requires that this report be prepared by the license holder responsible for the work and filed with the				
Department at the above address Information on Well O			or borehole. The second se		
(Landowner if borehole is not fo					
Owner Name Terry Relifo	14	Latitude: $34 \circ 56 \cdot 513$ "Longitude: $89 \circ 19 \cdot 874$ " 31 Method of Lat/Long (circle one): Conventional Survey,			
Mailing Address: 4236, hw		Method of Lat/Long (circle one): Conventional Survey,			
<u></u>			GPS Survey-grade GPS		
	20/117	NE 4NE 1/4 Sec 6	Twn 25 Rng 100		
<u>Lonnor</u> City State	e Zip Code	Distance Direction	Nearest Town		
Telephone No. (901 598 - 48		isly Miles NW	of Lannor		
Telephone No. (10) 913 - 10					
	Well / Bore				
Date drilling started: 12 34-08 Date dril	lling completed:	Cd Hole depth: 160	Hole diameter: <u>G 3/4</u>		
Location of the source of any surface water Method of dosing and volume of Chlorine	used for drilling: used in drilling and devel	opment: MA			
Logs run (circle all applicable). No log run Name of organization running log(s):	4 Electric Gamma Ray	Density Sonic Neutron	Other:		
Purpose of borehole (check one): Water We	IIGeotechnical/Geolo	ogical Investigation Ground	Source Heat Pump		
	urveyOther (<i>describe</i>)				
If drilling is not related to water well construction, skip the remainder of this block					
Purpose of Well (check one): Home <u>Industrial</u> Public Supply Irrigation Fish Culture Other:					
If a flowing well, method of flow regulation: Valve Other (describe)					
Static Water Level:					
Method of Measurement (circle one) steel tape electric tape air line other: <u>String Lucich</u>					
Well depth: 160 Well grouted to a depth of 10 feet Type of grout (circle one): Neat Cement Bentonite Mix					
Casing length: 150 feet Casing diameter: 4 inches Type of casing: 900					
Screen length: <u>10</u> feet Screen diameter: <u>4</u> inches Type of screen: <u>puc</u>					
Screen slot size: 010 inches Setting depth: From 150 feet to 160 feet					
Type of completion (circle all applicable):	Type of completion (circle all applicable): Gravel packed Underreamed Telescoped Open hole Natural Development				
Other (describe):					
Top of lap pipe or reduction in casing: feet. If telescoped or more than one screen, describe on next page					
Form: OLWR-SWR-1A (04/08)					

э.

1

JAN 2 3 2009 BY: OLWR

72

The sketch below only required for water wells

If well telescopes, show depths on sketch.


Ground Level

<u>pths on sketch</u> .			
	Description of Formations Encountered	From (depth)	
T	- clay dict	Ground Level	10
	led jourd	10	15
	sed elem	15	40
	winite soud	40	160
			+
			1
			-
			<u> </u>
			1
	······································		
	······································		
			1
			• • • • • • • • • • • • • • • • • • • •

Description of formations encountered must be provided for all

wells and boreholes, unless specifically exempted by regulations

If more than one screen, show location of each on sketch

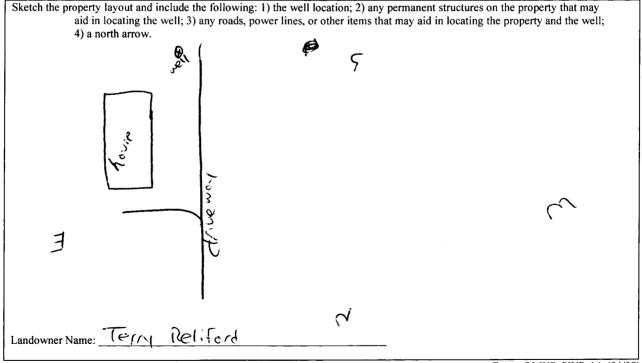

Form: OLWR-SWR-1A (04/08)

I certify that the well/borehole was drilled, constructed, and completed in accordance with all applicable requirements of the Mississippi Department of Environmental Quality and the Mississippi Department of Health regulations, if applicable, and state laws.

Meion 0-620 1-21-09 Print Name of Responsible Licensee and License No. Date

Signature of Licensee

RECEIVED

JAN 2 3 2009 BY: OLWR

STATE WELL REPORT				
County: Beston	Part 2 Pump Installer's Completion Report	For Office Use Only:		
Permit #:	Mississippi Department of Environmental Quality	Aquifer:		
Driller: Jones w. Masun	Office of Land and Water Resources P.O. Box 2309	D- 72		
Date completed: 12-34-00	Jackson, MS 39225 (601)961-5210	Well #:		
Copy information from block on Part 1	(601)961-5228 (fax)	Elevation:		

This part of the report must be completed by a licensed water well contractor or a licensed pump installer. A copy of Part 1 of the report must be attached and both parts filed with the Department at the above address within 30 days of well completion.

Well Owner Information		Well Location			
Owner Name:	TEIN Rel	iford	Latitude: 34-	56. 513 Longitude:	89.19.874
Mailing Address: 4736 hwy 72		Method of Lat/Long (check one): Conventional Survey,			
			USGS quad	, Hand-held GPS <u></u> , Sur	vey-grade GPS
	Lanne /	<u>us 3864</u> 2 ate Zip Code	NE 4NE	1/4 Sec 6 T 25	RIW
			Distance	Direction Nearest 7	Town
Telephone No. (901 598-4	4820	<u>[3]4</u> Miles	vin of Len	<u>/////////////////////////////////////</u>
	Pump Typ Circle one			Power Type Circle one	
Air Lift	Jet	Submersible	Diesel Engine	Gasoline Engine	Natural Gas
Bucket	Piston	Turbine	Electric Motor	Hand	Tractor PTO
Contration and	D (

Centrifugal	Rotary	Flowing Well	Windmill	Other (specify):	
Other (specify):			Horse Power Rating of	of Motor: <u> </u>	·
Date Pump Installed:	12-34-00	p	Setting Depth:	110	_feet
Rated Pump Capacity:	10	Gallons Per Minute	Number of Stages:	8	

Pump Test Data	Method of Measuring Water Level Circle one		
Date Well Tested: 12-24-0 cP			
	Air Line Electric Measuring Line Steel Tape		
Static Water Level (A): <u><u></u> <u></u>Feet Below Land Surface</u>	Other (specify): String I veight		
Pumping Water Level (B):Feet Below Land Surface	other (specify):		
Drawdown [(B) – (A)]:Feet Below Land Surface	For flowing well, measured shut in head: $\underline{\mathcal{N}}$ feet		
Test Pumping Rate: (🖄 Gallons Per Minute	Well yielded GPM with a drawdown of		
Duration of Pump Test (minimum 4 hours): <u></u> hours			

LUEDEDV CEDTIEV that the above statements are true to the heat of	f mu knowlodza
I HEREBY CERTIFY that the above statements are true to the best of	i my knowledge.
Joes w. Major 0-620	fors w. Mon
Print Name of Pump Installer and License No. (if applicable)	Signature of Pump Installer
	Form: OLWR-SWR-1B (04/08)
	RECEIVED

JAN 2 3 2009 BY: OLWR