

BENTON MISSISSIPPI BOARD OF WATER COMMISSIONERS

D 2001


WATER WELL DRILLERS LOG

11-27-63

Date: 11-27, 1963, Driller: Robert W. Wilson County Benton

(Name)

		Description & Color of Materials Sand, Clay, Red Clay, Shell, etc.	Thick- ness Feet	Depth Feet
(1) Owner of Land: <u>TROY HUNT</u> (Name)		<u>Red dirt</u>	<u>10</u>	<u>0-10</u>
<u>Lamar, Miss.</u> (Address)		<u>" Sand</u>	<u>30</u>	<u>10-40</u>
(2) Location: <u>025-01 W</u> <u>1/4, 1/4, Sec. T R S</u>		<u>" Clay</u>	<u>10</u>	<u>40-50</u>
<u>_____</u> miles <u>_____</u> of <u>_____</u> (distance) (direction) (Nearest Town)		<u>" "</u>	<u>20</u>	<u>50-70</u>
(3) Topography: _____ (Hilly) (Flat) (Level)		<u>White Sand</u>	<u>59</u>	<u>70-129</u>
(4) Purpose of Well: <u>Domestic</u> (Domestic Irrigation Municipal, Industrial, Other)				
Information upon completion of well:				
(1) Diameter <u>4</u> inches.				
(2) Total Depth <u>129</u> feet.				
(3) Water Level <u>100</u> feet below top of ground.				
(4) Cased to <u>129</u> , Size <u>4"</u>				
(5) Screen: Size <u>4"</u> , Length <u>6'</u>				
(6) Were any formations sealed against pollution? <u>_____</u> yes, <u>X</u> no.				
If YES depth of formation _____				
Why _____				
Drillers Remarks: _____				

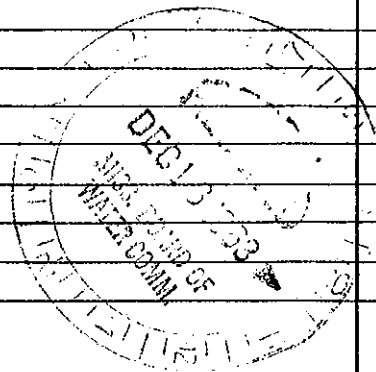

(Use Back Side)

Well No.

Mail this copy to Board of Water Commissioners 429 Miss. St. Jackson, Miss.