

D 2002

BOARD OF WATER COMMISSIONERS

12-5-63

WELL DRILLERS LOG

Date: 12-5, 1963, Driller: Robert W. Wilson County Benton

(Name)

(1) Owner of Land <u>J. H. Carpenter</u> (Name)	Description & Color of Materials Sand, Clay, Red Clay, Shell, etc.	Thick- ness Feet	Depth Feet
<u>Michigan City, Miss.</u> (Address)	<u>Red Sand</u>	<u>10</u>	<u>0-10</u>
(2) Location: <u>1/4, 1/4, Sec. 025 01 W</u> T R	<u>" Clay</u>	<u>10</u>	<u>10-20</u>
<u>10 miles South</u> of <u>M.C.</u> (distance) (direction) (Nearest Town)	<u>white sand</u>	<u>10</u>	<u>20-30</u>
(3) Topography: _____ (Hilly) (Flat) (Level)	<u>" clay</u>	<u>10</u>	<u>30-40</u>
(4) Purpose of Well: <u>Domestic</u> (Domestic Irrigation Municipal, Industrial, Other)	<u>" " & Sand</u>	<u>10</u>	<u>40-50</u>
	<u>" " "</u>	<u>30</u>	<u>50-80</u>

Information upon completion of well:


- (1) Diameter 4 inches.
- (2) Total Depth 80 feet.
- (3) Water Level 45 feet below top of ground.
- (4) Cased to 80', Size 4"
- (5) Screen: Size 4", Length 6'
- (6) Were any formations sealed against pollution?
_____ yes, X no.

If YES depth of formation _____

Why _____

Drillers Remarks: _____

Mail this copy to Board of Water Commissioners 429 Miss. St. Jackson, Miss.

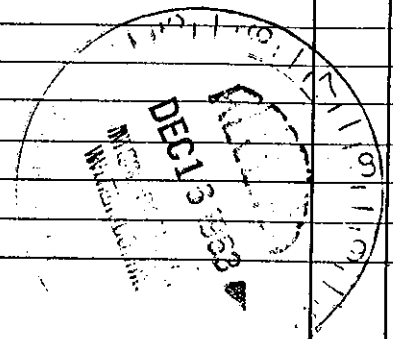

(Use Back Side)

Well No.