

BENTON MISSISSIPPI BOARD OF WATER COMMISSIONERS

D-~~2~~ 2003
5-7-64

WATER WELL DRILLERS LOG

Date: 5-7, 1964, Driller: Robert W. Wilson County Benton

(Name)

(1) Owner of Land: <u>Fred Holland</u> (Name)	Description & Color of Materials Sand, Clay, Red Clay, Shell, etc.	Thick- ness Feet	Depth Feet
<u>Hudsonville Miss.</u> (Address)			
(2) Location: <u>02501W</u> <u>1/4</u> , <u>1/4</u> , Sec. <u>T R</u>	<u>Red clay</u>	<u>10</u>	<u>0-10</u>
<u>_____</u> miles <u>_____</u> of <u>_____</u> (distance) (direction) (Nearest Town)	<u>Red sand</u>	<u>60</u>	<u>10-70</u>
(3) Topography: <u>X</u> (Hilly) (Flat) (Level)	<u>White sand</u>	<u>10</u>	<u>70-80</u>
(4) Purpose of Well: <u>Domestic</u> (Domestic Irrigation Municipal, Industrial, Other)	<u>White sand + clay</u>	<u>20</u>	<u>80-100</u>
	<u>White sand</u>	<u>15</u>	<u>100-115</u>

Information upon completion of well:


- (1) Diameter 4 inches.
- (2) Total Depth 115 feet.
- (3) Water Level 80 feet below top of ground.
- (4) Cased to 114, Size 4"
- (5) Screen: Size 6", Length 4'
- (6) Were any formations sealed against pollution?
_____ yes, X no.

If YES depth of formation _____

Why _____

Drillers Remarks: _____

Mail this copy to Board of Water Commissioners 429 Miss. St. Jackson, Mis:

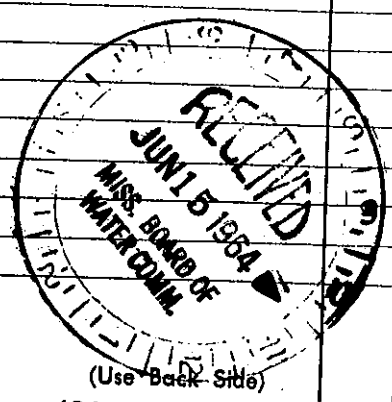

Well No.