


BENTON MISSISSIPPI BOARD OF WATER COMMISSIONERS

D 2004
5-6-65

WATER WELL DRILLERS LOG

Date: 5-6, 1965, Driller: ROBERT W. WILSON County BENTON
(Name)

| | Description & Color of Materials Sand, Clay, Red Clay, Shell, etc. | Thick- ness Feet | Depth Feet |
|---|---|------------------------|----------------|
| (1) Owner of Land: <u>MARVIN BAILEY</u> (Name) | <u>BLACK CLAY</u> | <u>20</u> | <u>0-20</u> |
| <u>LAMAR, MISS.</u> (Address) | <u>RED SAND</u> | <u>100</u> | <u>20-120</u> |
| (2) Location: <u>1/4, 1/4, Sec. 0251W</u> <u>Y R</u> | <u>WHITE SAND</u> | <u>41</u> | <u>120-161</u> |
| <u>5</u> miles <u>W</u> of <u>LAMAR</u> (distance) (direction) (Nearest Town) | | | |
| (3) Topography: <u>HILLY</u> (Hilly) (Flat) (Level) | | | |
| (4) Purpose of Well: <u>HOME</u> (Domestic Irrigation Municipal, Industrial, Other) | | | |
| Information upon completion of well: | | | |
| (1) Diameter <u>4</u> inches. | | | |
| (2) Total Depth <u>161</u> feet. | | | |
| (3) Water Level <u>100</u> feet below top of ground. | | | |
| (4) Cased to <u>161</u> , Size <u>4"</u> | | | |
| (5) Screen: Size <u>6"</u> , Length <u>4'</u> | | | |
| (6) Were any formations sealed against pollution? | | | |
| _____ yes, <u>X</u> no. | | | |
| If YES depth of formation _____ | | | |
| Why _____ | | | |
| Drillers Remarks: _____ | | | |
| _____ | | | |
| _____ | | | |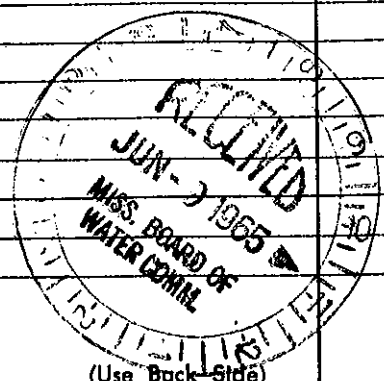
Well No.

Mail this copy to Board of Water Commissioners 429 Miss. St. Jackson, Miss