

MISSISSIPPI DEPARTMENT OF NATURAL RESOURCES


Bureau of Land and Water Resources

Southport Mall

P.O. Box 10631

Jackson, Mississippi 39209

WATER WELL DRILLERS LOG

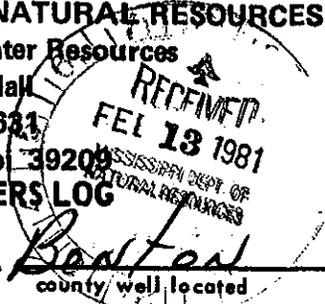

Benton  
D 2029  
1-14-81  
1-14-81  
 date well completed

Wilson Well Co  
 firm name

Benton  
 county well located

LANDOWNER: Bobby Jones  
PO Box 458  
Lamar, Miss  
 (mailing address)

description of formations encountered	from	to
<u>Red Clay Red Sand</u>	<u>0</u>	<u>30</u>
<u>Red Sand</u>	<u>30</u>	<u>150</u>
<u>Red Clay, White clay, Wh Sand</u>	<u>150</u>	<u>180</u>
<u>White Sand</u>	<u>180</u>	<u>195</u>

WELL LOCATION:  
 sec. 28 T. 2 N R. 1 E  
3 miles SE of Lamar  
 (distance) (direction) (nearest town)

WELL PURPOSE: Home  
 (home, irrigation, municipal, industrial)

WELL COMPLETION DATA:

(1) diameter (inches) 4

(2) total depth (feet) 195

(3) static water level (feet) 160 below above top of ground.

(4) casing Plastic, 185  
 (material) (depth)  
4 if telescope see back.  
 (size)

(5) screen 10 (length) (depth to top)  
4 Plastic  
 (size) (material)

(6) pump 3/4 10  
 (HP) (yield gpm)  
electric  
 (type power)

(7) electric log NO  
 (yes or no)

(organization running log)

(8) how well bottom plugged Plastic Cap 4"

DRILLERS REMARKS:

