

Benton
D 2031
2/16/81
2-16

MISSISSIPPI DEPARTMENT OF NATURAL RESOURCES


Bureau of Land and Water Resources

Southport Mall

P.O. Box 1063

Jackson, Mississippi 39209

WATER WELL DRILLERS LOG

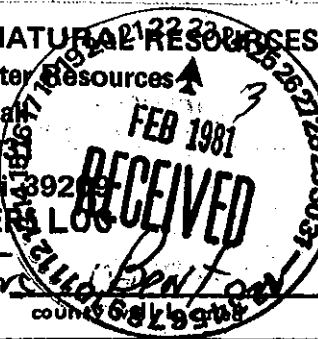

date well completed

firm name

Wilson Well Co, Inc

LANDOWNER: Mrs. J. L. Lacy
RT #1 Box 254
Lamar, Miss
 (mailing address)

description of formations encountered

from to

<u>Red Clay</u>	<u>Red Sand</u>	<u>0</u>	<u>30</u>
<u>Red Sand</u>		<u>30</u>	<u>60</u>
<u>Red Sand</u>	<u>White clay</u>	<u>60</u>	<u>70</u>
<u>White clay</u>	<u>White Sand</u>	<u>70</u>	<u>105</u>
<u>White Sand</u>		<u>105</u>	<u>153</u>

WELL LOCATION:

? sec. 26 T. 1 N. R. 1 E.
3/4 miles S of Lamar
 (distance) (direction) (nearest town)

WELL PURPOSE:

(home, irrigation, municipal, industrial)

Home

WELL COMPLETION DATA:

- (1) diameter (inches) 4
- (2) total depth (feet) 143
- (3) static water level (feet) 95 below above top of ground.
- (4) casing plastic, 133,
 (material) (depth)
4"
 (size) if telescope see back.
- (5) screen 10, 133
 (length) (depth to top)
4", plastic
 (size) (material)
- (6) pump 3/4 10
 (HP) (yield gpm)
electric
 (type power)
- (7) electric log No
 (yes or no)
 (organization running log)
- (8) how well bottom plugged 4"
plastic cap

DRILLERS REMARKS:

DEPT. OF NATURAL RESOURCES
 BUREAU OF LAND & WATER RESOURCES

FEB 23 1981

