

BENTON  
E

MISSISSIPPI BOARD OF WATER COMMISSIONERS

E 300

10-25-60 WATER WELL DRILLERS LOG

Date: Oct. 25, 60, Driller: Robert W. Wilson County: Benton

(Name)

(1) Owner of Land:	Description & Color of Materials Sand, Clay, Red Clay, Shell, etc.	Thick- ness Feet	Depth Feet
<u>Mrs. R.L. M<sup>rs</sup> Collier</u> (Name) <u>Fishland, Miss.</u> (Address)			
(2) Location: <u>3</u> miles <u>North</u> of <u>Fishland</u> (distance) (direction) (Nearest Town)			
(3) Topography: <u>Home &amp; Farm</u> (Hilly) (Flat) (Level)	<u>Red Clay</u>	<u>20'</u>	<u>0'-20'</u>
(4) Purpose of Well:	<u>Red Sand</u>	<u>40'</u>	<u>20'-60'</u>
(Domestic Irrigation Municipal, Industrial, Other)	<u>White Sand</u>	<u>40'</u>	<u>60'-100'</u>


Information upon completion of well:

- (1) Diameter 4" inches.
- (2) Total Depth 100' feet.
- (3) Water Level 80' feet below top of ground.
- (4) Cased to 100', Size 4"
- (5) Screen: Size 4", Length 6'
- (6) Were any formations sealed against pollution?  
 yes,  no.

If YES depth of formation \_\_\_\_\_

Why \_\_\_\_\_

Drillers Remarks: \_\_\_\_\_

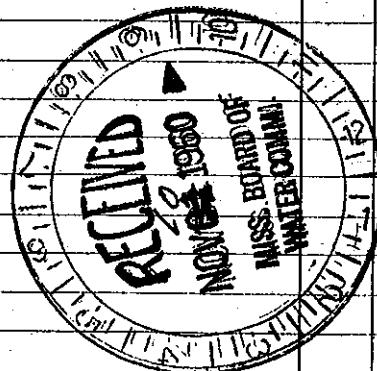

(Use Back Side)

Well No.

Mail this copy to Board of Water Commissioners 429 Miss. St. Jackson, Miss