

Benton
E 28
2-66

MISSISSIPPI
 BOARD OF WATER COMMISSIONERS
 416 North State Street
 Jackson, Mississippi 39201

CODED

WATER WELL DRILLERS LOG

2-15 1966 Robert W. Wilson Benton
 date well completed firm name county well located

LANDOWNER: Myatt Thomas
Oakland
Miss.
 (mailing address)


description of formations encountered	from	to
	0	
<u>Red Sand</u>	10'	40'
<u>white clay + Red Sand</u>	40'	60'
<u>white clay + white sand</u>	60'	70'
<u>white Sand</u>	70'	108'

WELL LOCATION:
 sec. 5 T 2 N R. 1 E
1 1/2 miles S-72 Hwy of Oakland
 (distance) (direction) (nearest town)

WELL PURPOSE: Home
 (home, irrigation, municipal, industrial)

- WELL COMPLETION DATA:
- (1) diameter (inches) 4"
 - (2) total depth (feet) 106'
 - (3) static water level (feet) 76' below above top of ground.
 - (4) casing Plastic 98'
 (material) (depth)
4"
 (size) If telescope see back.
 - (5) screen 8' 98'
20 gaw (length) (depth to top)
4" Slotted Pipe G. Pac.
 (size) (material)
 - (6) pump 1/2 (HP) (yield gpm)
Elect.
 (type power)
 - (7) electric log NO
 (yes or no)
 (organization running log)
 - (8) how well bottom plugged 4"
Plastic Cap

CODED

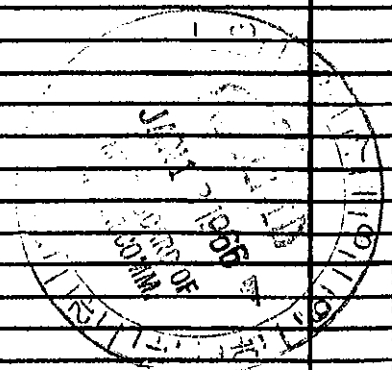

DRILLERS REMARKS: