

Benton
E 29
3-66

MISSISSIPPI
 BOARD OF WATER COMMISSIONERS
 416 North State Street
 Jackson, Mississippi 39201

CODED

WATER WELL DRILLERS LOG

3-28 1966 Robert W. Wilson Benton
 date well completed firm name county well located

LANDOWNER: J. W. Hardaway
Michigan City
Miss.
 (mailing address)


description of formations encountered	from	to
	0	
<u>Red Clay</u>	10	30
<u>Red Clay & Red Sand</u>	30	50
<u>Red clay & white sand</u>	50	60
<u>White Sand</u>	60	87

WELL LOCATION:
 sec. 9 T. 2 N. R. 10 E.
1 miles S 22 1/2 W of Mich. City
 (distance) (direction) (nearest town)

WELL PURPOSE: Home
 (home, irrigation, municipal, industrial)

- WELL COMPLETION DATA:
- (1) diameter (inches) 4"
 - (2) total depth (feet) 84"
 - (3) static water level (feet) 54 ^{below} _{above} top of ground.
 - (4) casing plastic 76
 (material) (depth)
4"
 (size) if telescope see back.
 - (5) screen 8' 76'
20 gaw (length) (depth to top)
4" (size) Slotted pipe (material) gpc.
 - (6) pump 1/2 (HP) (yield gpm)
Elect.
 (type power)
 - (7) electric log NO
 (yes or no)
 (organization running log)
 - (8) how well bottom plugged 4"
plastic cap

CODED

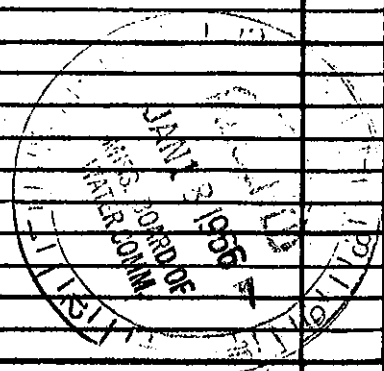

DRILLERS REMARKS: