

Benton  
E30  
4-66

MISSISSIPPI  
BOARD OF WATER COMMISSIONERS  
416 North State Street  
Jackson, Mississippi 39201

**CODED**

WATER WELL DRILLERS LOG

4-5 1966 Robert W. Wilson Benton  
date well completed firm name county well located

LANDOWNER: Raymond Stecke  
Michigan City  
Miss  
(mailing address)


description of formations encountered	from	to
Red Clay	0	20
Red Sand	20	30
Red Sand white clay	30	60
White sand	60	100

WELL LOCATION:  
sec. 8 T 2 N R. 10 E  
1 1/4 miles S-72 My of Mich. City  
(distance) (direction) (nearest town)

WELL PURPOSE: home  
(home, irrigation, municipal, industrial)

- WELL COMPLETION DATA:
- (1) diameter (inches) 4"
  - (2) total depth (feet) 100'
  - (3) static water level (feet) 70' below top of ground.
  - (4) casing Plastic 92' (material) (depth)  
4" (size) if telescope see back.
  - (5) screen 8' 92' (length) (depth to top)  
20 gpm (size) (material)  
4" Gravel Pac Slotted Pipe
  - (6) pump 1/2 (HP) (yield gpm)  
Elect. (type power)
  - (7) electric log NO (yes or no)  
(organization running log)
  - (8) how well bottom plugged 4"  
Plastic cap

**CODED**

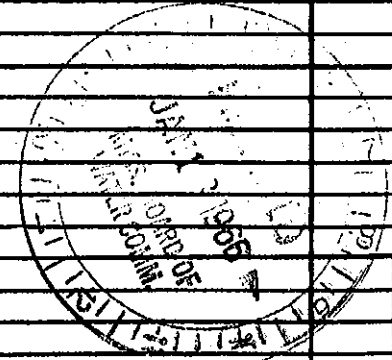

DRILLERS REMARKS: