

Benton  
E35  
12-66

MISSISSIPPI  
BOARD OF WATER COMMISSIONERS  
416 North State Street  
Jackson, Mississippi 39201

**CODED**

WATER WELL DRILLERS LOG

12-1966 date well completed      Robert W. Wilson firm name      Benton county well located

LANDOWNER: Delphus Hicks  
Lamar  
Miss.  
(mailing address)


description of formations encountered	from	to
Red clay & sand	0	20
Red sand & white clay	20	50
Red sand	50	100
Red sand & white clay	100	110
white sand	110	180

WELL LOCATION:  
sec. 29 T 2 N R. 1 E  
5 miles E of Lamar  
(distance) (direction) (nearest town)

WELL PURPOSE: Home  
(home, irrigation, municipal, industrial)

- WELL COMPLETION DATA:
- (1) diameter (inches) 4"
  - (2) total depth (feet) 180'
  - (3) static water level (feet) 145' below top of ground.
  - (4) casing Plastic 172'  
(material) (depth)  
4" if telescope see back.  
(size)
  - (5) screen 8' 172'  
20gaw (length) (depth to top)  
4" Gal. Pac Slotted Pipe  
(size) (material)
  - (6) pump 3/4 (HP) (yield gpm)  
Elect.  
(type power)
  - (7) electric log No  
(yes or no)  
(organization running log)
  - (8) how well bottom plugged 4"  
Plastic cap

**CODED**

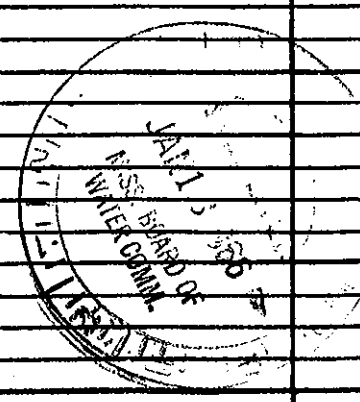

DRILLERS REMARKS: