

*Benton*  
**E 37**  
 1-67

MISSISSIPPI  
 BOARD OF WATER COMMISSIONERS  
 416 North State Street  
 Jackson, Mississippi 39201

WATER WELL DRILLERS LOG

**CODED**

1-26 1967 *Robert Wilson* *Benton*  
 date well completed firm name county well located

LANDOWNER: *Malcolm Atkins*  
*Michigan City*  
 (mailing address)


description of formations encountered	from	to
<i>Red clay</i>	<i>0</i>	<i>20</i>
<i>Red sand</i>	<i>20</i>	<i>40</i>
<i>White clay white sand</i>	<i>40</i>	<i>60</i>
<i>White sand</i>	<i>60</i>	<i>100</i>
<i>White sand white clay</i>	<i>100</i>	<i>118</i>

WELL LOCATION:  
 sec. *20* T. *2* N. R. *1* E.  
*4* miles *N* of *Oshland*  
 (distance) (direction) (nearest town)

WELL PURPOSE:  
 (home, irrigation, municipal, industrial)

- WELL COMPLETION DATA:
- diameter (inches) *4"*
  - total depth (feet) *118'*
  - static water level (feet) *60'* below above top of ground
  - casing *Plastic* *114'*  
 (material) (depth)  
*4"* if telescope see back.  
 (size)
  - screen *4'* *114'*  
 (length) (depth to top)  
*4"* *Gravel sack*  
 (size) (material)
  - pump *1/2* *10*  
 (HP) (yield gpm)  
*Elect.*  
 (type power)
  - electric log *✓*  
 (yes or no)  
 (organization running log)
  - how well bottom plugged *4"*  
*Plastic cap*

**CODED**

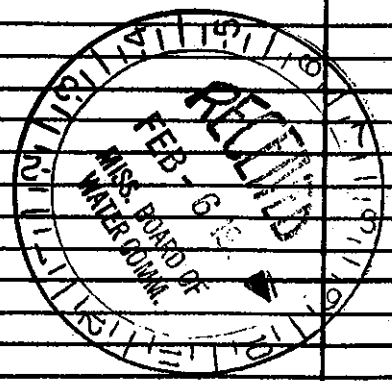

DRILLERS REMARKS: