

Benton
E 38
2-67

MISSISSIPPI BOARD OF WATER COMMISSIONERS

WATER WELL DRILLERS LOG

CODED

Date: Feb 16, 1967, Driller: Larry Carpenter County Benton
(When well drilled) (Name) (Where well is located)

(1) Owner of Land:	Description & Color of Materials Sand, Clay, Red Clay, Shell, etc.	Thick- ness Feet	Dept Feet
<u>Helma Emmett</u> (Name)	<u>Surface Soil</u>	<u>12</u>	<u>12</u>
<u>Ashland, Miss. RFD.</u> (Address)	<u>Medium Red Sand</u>	<u>33</u>	<u>45</u>
(2) Location: <u>NW 1/4, NW 1/4, Sec 22, T25R1E</u>	<u>White medium sand</u>	<u>5</u>	<u>51</u>
<u>5</u> miles <u>north</u> of <u>Ashland</u> (distance) (direction) (Nearest Town)	<u>white clay</u>	<u>3</u>	<u>54</u>
(3) Topography: <u>Hilly</u> (Hilly) (Flat) (Level)	<u>white coarse sand</u>	<u>14</u>	<u>68</u>
(4) Purpose of Well: <u>Resident</u> (Domestic Irrigation Municipal, Industrial, Other)			

Information upon completion of well:

- (1) Diameter 4 in. inches.
- (2) Total Depth 68 feet.
- (3) Water Level 35 feet below top of ground.
- (4) Cased to 61, Size 4 in.
- (5) Screen: Size 4 in., Length 7 ft.
- (6) Were any formations sealed against pollution?
_____ yes, X no.

If YES depth of formation _____

Why _____


Drillers Remarks: _____

Yield in gpm: Inadequate

Size pump: 1/2 H.P. - Submersible Pump

Type power: 220 volt - Elec.

CODED

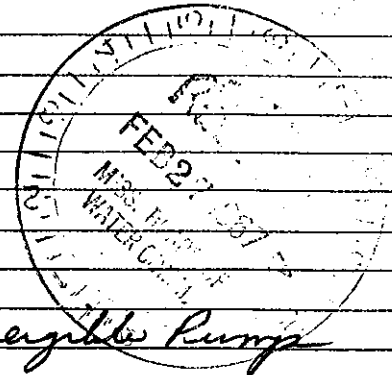

Mail this copy to Board of Water Commissioners 429 Miss. St. Jackson, Miss.