

Benton
E46
11-67

MISSISSIPPI
 BOARD OF WATER COMMISSIONERS
 416 North State Street
 Jackson, Mississippi 39201

CODED

WATER WELL DRILLERS LOG

11-20 19 67 Robert Wilson Benton
 date well completed firm name county well located

LANDOWNER: Tommy Mauden
 Ashland Miss.
 (mailing address)

description of formations encountered	from	to
Red clay	0	20
Red sand	20	40
Red sand white clay	40	60
white sand	60	100
white sand rock &	100	120
Blue clay		


WELL LOCATION:
 sec. 11 T 2 N R 1 E
 S W
 3 miles E of Spring Hill
 (distance) (direction) (nearest town)

WELL PURPOSE:
 (home, irrigation, municipal, industrial)

WELL COMPLETION DATA:

(1) diameter (inches) 4"
 (2) total depth (feet) 114'
 (3) static water level (feet) 60' below top of ground
 (4) casing Plastic, 106'
 (material) (depth)
 4" (size) if telescope see back.
 (5) screen 8' length, 106' depth to top
 (length) (depth to top)
 4" Gravel pack (size) (material)
 (6) pump 1/2 HP, 10 (HP) (yield gpm)
 Elect. (type power)
 (7) electric log (yes or no)
 (organization running log)
 (8) how well bottom plugged 4"
 Plastic cap

CODED

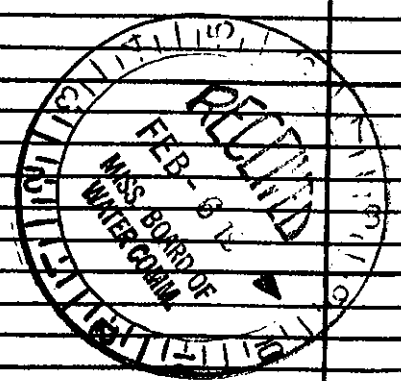

DRILLERS REMARKS: