

Benton  
E 49  
Co 68

MISSISSIPPI  
BOARD OF WATER COMMISSIONERS  
416 North State Street  
Jackson, Mississippi 39201

**CODED**

WATER WELL DRILLERS LOG

June 14, 1968 Bumpus Well Co. Benton  
date well completed firm name county well located

LANDOWNER: Ray Allen  
Ashland, Miss.  
  
(mailing address)


description of formations encountered	from	to
<u>Red Clay</u>	<u>0</u>	<u>10</u>
<u>    "    "    "    "    "</u>	<u>10</u>	<u>130</u>

WELL LOCATION:  
sec. 5 T. 8 N. R. 1 E  
1/2 miles North of Ashland  
(distance) (direction) (nearest town)

WELL PURPOSE: Dwelling  
(home, irrigation, municipal, industrial)

- WELL COMPLETION DATA:
- (1) diameter (inches) 4"
  - (2) total depth (feet) 130
  - (3) static water level (feet) 95 <sup>below</sup> above top of ground.
  - (4) casing Plastic, 134 Ft.  
(material) (depth)
  - 1/2 (size) if telescope see back.
  - (5) screen 60 Ft., 124 Ft.  
(length) (depth to top)
  - 609, gravel wall  
(size) (material)
  - (6) pump 3/4 10 gal  
(HP) (yield/gpm)
  - Elect-  
(type power)
  - (7) electric log (yes) or no  
  
(organization running log)
  - (8) how well bottom plugged Plastic Cap

**CODED**

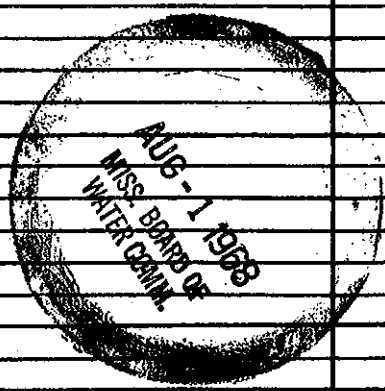

DRILLERS REMARKS: