

BENTON MISSISSIPPI BOARD OF WATER COMMISSIONERS

E 2003

2-7-64

WATER WELL DRILLERS LOG

Date: 2-7, 1964, Driller: Robert W. Wilson County Benton
(Name)

(1) Owner of Land: <u>C. L. McStinzie</u> <small>(Name)</small>	Description & Color of Materials Sand, Clay, Red Clay, Shell, etc.	Thick- ness Feet	Depth Feet
<u>Ashland Miss</u> <small>(Address)</small>	<u>Red Clay - Red Sand</u>		<u>25</u>
(2) Location: <u>1/4</u> , <u>1/4</u> , Sec. <u> </u> T. <u> </u> R. <u> </u>	<u>Red Sand</u>		<u>50</u>
<u>6</u> miles <u>N</u> of <u>Ashland</u> <small>(distance) (direction) (Nearest Town)</small>	<u>" "</u>		<u>60</u>
(3) Topography: <u>X</u> <small>(Hilly) (Flat) (Level)</small>	<u>Yellow " "</u>		<u>70</u>
(4) Purpose of Well: <u>Home</u> <small>(Domestic Irrigation Municipal, Industrial, Other)</small>	<u>" "</u>		<u>80</u>
	<u>White " "</u>		<u>90</u>
	<u>" "</u>		<u>115</u>


Information upon completion of well:

- (1) Diameter 4 inches.
- (2) Total Depth 115 feet.
- (3) Water Level 70 feet below top of ground.
- (4) Cased to 115, Size 4.
- (5) Screen: Size 4, Length 61.
- (6) Were any formations sealed against pollution?
 yes, no.

If YES depth of formation _____

Why _____

Drillers Remarks: _____

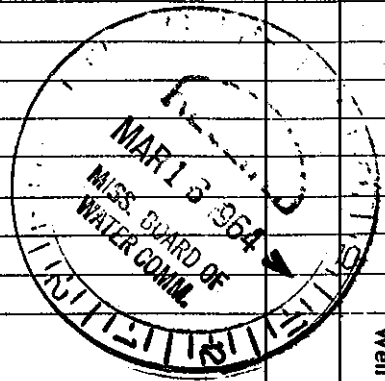

(Use Back Side)

Well No. _____

Mail this copy to Board of Water Commissioners 429 Miss. St. Jackson, Miss.