

BENTON MISSISSIPPI BOARD OF WATER COMMISSIONERS

E 2084
1-8-65

WATER WELL DRILLERS LOG

Date: Jan. 8, 1965, Driller: Robert Wilson County Benton
(Name)

		Description & Color of Materials Sand, Clay, Red Clay, Shell, etc.	Thick- ness Feet	Depth Feet
(1) Owner of Land: <u>V. E. Hunt</u> (Name)		<u>Red clay</u>	<u>10</u>	<u>10</u>
<u>Michigan City</u> (Address)		<u>" sand</u>	<u>40</u>	<u>50</u>
(2) Location: <u>1/4</u> , <u>1/4</u> , Sec. <u>T</u> , <u>R</u>		<u>white clay</u>	<u>10</u>	<u>60</u>
<u>4</u> miles <u>N</u> , of <u>Ashland</u> (distance) (direction) (Nearest Town)		<u>" sand</u>	<u>62</u>	<u>122</u>
(3) Topography: <u>X</u> (Hilly) (Flat) (Level)				
(4) Purpose of Well: <u>Domestic</u> (Domestic Irrigation Municipal, Industrial, Other)				


Information upon completion of well:

- (1) Diameter 4 inches.
- (2) Total Depth 122 feet.
- (3) Water Level 60 feet below top of ground.
- (4) Cased to 122, Size 4
- (5) Screen: Size 6, Length 4
- (6) Were any formations sealed against pollution?
 yes, no.

If YES depth of formation _____

Why _____

Drillers Remarks: _____

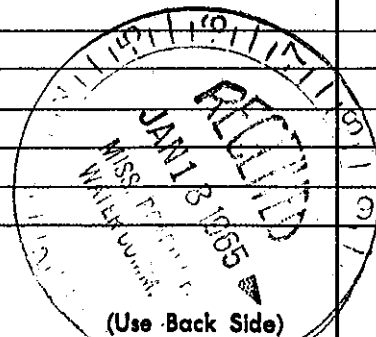

Well No.

Mail this copy to Board of Water Commissioners 429 Miss. St. Jackson, Miss.