

BENTON
E 2017
4-12-78

MISSISSIPPI  
BOARD OF WATER COMMISSIONERS  
416 North State Street  
Jackson, Mississippi 39201

### WATER WELL DRILLERS LOG

APR 12 1978 Billy R. Simpson BENTON  
date well completed firm name county well located

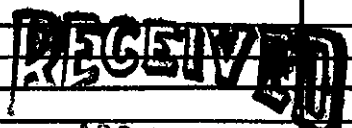
LANDOWNER:  
LEE MCKENZIE  
MICHIGAN CITY, MISS  
(mailing address)

description of formations encountered	from to	
<u>SURFACE CLAY</u>	<u>0</u>	<u>16</u>
<u>RED SAND</u>	<u>16</u>	<u>83</u>
<u>FINE WHITE SAND</u>	<u>83</u>	<u>100</u>
<u>COARSE SAND</u>	<u>100</u>	<u>133</u>

WELL LOCATION:  
sec. P T. 2 R. 1 E  
S W S W  
8 miles N of ASHLAND  
(distance) (direction) (nearest town)

WELL PURPOSE: Home  
(home, irrigation, municipal, industrial)

WELL COMPLETION DATA:  
(1) diameter (inches) 4  
(2) total depth (feet) 133  
(3) static water level (feet) 77 below above top of ground.  
(4) casing POC 127  
(material) (depth)  
(size) if telescope see back.  
(5) screen 6' 127  
(length) (depth to top)  
4" POC  
(size) (material)  
(6) pump 3/4 10  
(HP) (yield gpm)  
Eloc  
(type power)  
(7) electric log No  
(yes or no)  
(organization running log)  
(8) how well bottom plugged POC  
CAP

APR 24 1978

DRILLERS REMARKS:

MISS. BOARD OF WATER COMM.