


BENTON
E 2021
9-26-78

**MISSISSIPPI
BOARD OF WATER COMMISSIONERS**
416 North State Street
Jackson, Mississippi 39201

WATER WELL DRILLERS LOG

9-26 1978 Andrew Well Co. Inc Benton
 date well completed firm name county well located

LANDOWNER:	description of fomations encountered	from	to
<u>Willie B. Redford</u> <u>Rt. 1 Lamar, Miss</u> (mailing address)			
WELL LOCATION:			
sec. <u>2</u> <u>T</u> <u>2</u> <u>S</u> R. <u>1</u> <u>W</u> (distance) (direction) (nearest town)			
WELL PURPOSE: (home, irrigation, municipal, industrial)			
WELL COMPLETION DATA:			
(1) diameter (inches) <u>4</u>			
(2) total depth (feet) <u>100</u>			
(3) static water level (feet) <u>120</u> below above top of ground.			
(4) casing <u>PVC</u> , <u>90</u> (material) (depth)			
<u>4</u> If telescope see back. (size)			
(5) screen <u>10</u> , (depth to top) (length) (material)			
<u>4</u> , <u>ground packed</u> (size) (material)			
(6) pump <u>3/4</u> , <u>10</u> (HP) (yield gpm)			
<u>electric</u> (type power)			
(7) electric log <input checked="" type="checkbox"/> (yes or no)			
(organization running log)			
(8) how well bottom plugged <u>4"</u> <u>plastic cap</u>			
DRILLERS REMARKS:			

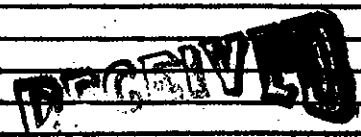

OCT 3 1978

TER COM