

BENTON
E 2054
7/24/85

MISSISSIPPI DEPARTMENT OF NATURAL RESOURCES
Bureau of Land and Water Resources
Southport Mall
P.O. Box 10631
Jackson, Mississippi 39209
WATER WELL DRILLERS LOG

July 24 1985 Billy R Simpson BENTON
date well completed firm name county well located


LANDOWNER:	description of formations encountered	from	to
STANLEY LINCOLN	SURFACE CLAY	0	16
ASHLAND, MISS	SAND	16	67
(mailing address)	WHITE CLAY	67	68
	COARSE SAND	68	89

WELL LOCATION:
sec 2 T 2 R 1 E
12 miles N of ASHLAND
(distance) (direction) (nearest town)

WELL PURPOSE: HOME
(home, irrigation, municipal, industrial)

- WELL COMPLETION DATA:
- (1) diameter (inches) 4
 - (2) total depth (feet) 89
 - (3) static water level (feet) 55 below top of ground.
 - (4) casing POC 79
(material) (depth)
 - (size) If telescope see back.
 - (5) screen 10 79
(length) (depth to top)
 - 4 POC
(size) (material)
 - (6) pump 1/2 10
(HP) (yield gpm)
 - Elec
(type power)
 - (7) electric log NO
(yes or no)
 - (organization running log)
 - (8) how well bottom plugged POC
CAP

DRILLERS REMARKS:

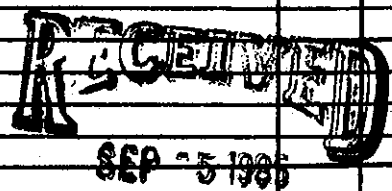

Department of Natural Resources
Bureau of Land and Water Resources