

Benton  
F18  
7-666

MISSISSIPPI  
BOARD OF WATER COMMISSIONERS  
416 North State Street  
Jackson, Mississippi 39201

**CODED**

WATER WELL DRILLERS LOG

7-29-1966 date well completed Robert M. Wilson firm name Benton county well located

LANDOWNER: Junior L. Roberson  
Saulsbury  
Miss.  
(mailing address)


description of formations encountered	from	to
Red & white clay	0	10
white & blue clay	10	20
Blue clay	20	110
Blue clay & sand	110	140
White sand & clay	140	150
White sand	150	184

WELL LOCATION:  
sec. 15 T 2 N R 2 E  
3 miles E of Canner  
(distance) (direction) (nearest town)

WELL PURPOSE: none  
(home, irrigation, municipal, industrial)

- WELL COMPLETION DATA:
- (1) diameter (inches) 4"
  - (2) total depth (feet) 184'
  - (3) static water level (feet) 155' <sup>below</sup> above top of ground.
  - (4) casing Plastic, 180' (material) (depth)  
4" (size) if telescope see back.
  - (5) screen 4" 180' (length) (depth to top)  
4" Gals. Pac Slotted Pipe (size) (material)
  - (6) pump 3/4 (HP) (yield gpm)  
Elect (type power)
  - (7) electric log NO (yes or no)  
(organization running log)
  - (8) how well bottom plugged 4" plastic cap

**CODED**

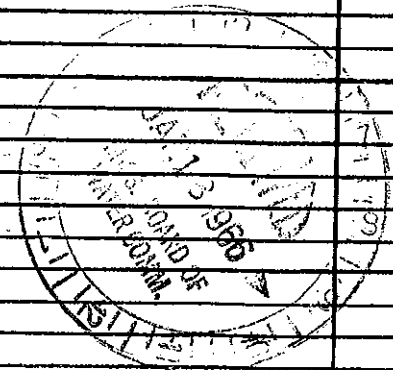

DRILLERS REMARKS: