

<i>Benton</i>
<i>719</i>
<i>1-67</i>

MISSISSIPPI
 BOARD OF WATER COMMISSIONERS
 416 North State Street
 Jackson, Mississippi 39201

CODED

WATER WELL DRILLERS LOG

1-3 19*67* *Robert Wilson* *Benton*
 date well completed firm name county well located

LANDOWNER: *Ted Childress*
Ashland
Miss.
 (mailing address)


WELL LOCATION:
 sec 9 T 2 N S 2 R 2 E W
 miles of *Brody*
 (distance) (direction) (nearest town)

WELL PURPOSE:
 (home, irrigation, municipal, industrial)

- WELL COMPLETION DATA:
- diameter (inches) 4"
 - total depth (feet) 260'
 - static water level (feet) 210' below above top of ground.
 - casing Plastic, 252'
 (material) (depth)
4" if telescope see back.
 (size)
 - screen 8', 252'
 (length) (depth to top)
4", Slotted Pipe
 (size) (material)
 - pump 3/4 18
 (HP) (yield gpm)
Elect.
 (type power)
 - electric log
 (yes or no)
 - how well bottom plugged 4"
Plastic cap

description of formations encountered	from	to
<i>Red clay</i>	<i>0</i>	<i>10</i>
<i>Red sand</i>	<i>10</i>	<i>70</i>
<i>Blue clay & Rock</i>	<i>70</i>	<i>120</i>
<i>Blue clay</i>	<i>120</i>	<i>200</i>
<i>Blue clay & Rock</i>	<i>200</i>	<i>210</i>
<i>Blue clay white sand</i>	<i>210</i>	<i>220</i>
<i>White sand Blue clay</i>	<i>220</i>	<i>230</i>
<i>White sand</i>	<i>230</i>	<i>276</i>

CODED

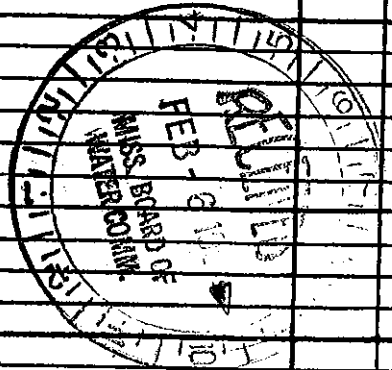

DRILLERS REMARKS: