

Benton
720
6-67

MISSISSIPPI
BOARD OF WATER COMMISSIONERS
416 North State Street
Jackson, Mississippi 39201

CODED

WATER WELL DRILLERS LOG

6-8 1967 Robert Wilson Benton
date well completed firm name county well located

LANDOWNER: Cecil Russeau
Askland Miss.
(mailing address)

WELL LOCATION:
sec. 19 T. 2 N. R. 3 E.
S. W.
7 miles S of Hopewell
(distance) (direction) (nearest town)

WELL PURPOSE:
(home, irrigation, municipal, industrial)


WELL COMPLETION DATA:

(1) diameter (inches) 4"
(2) total depth (feet) 185'
(3) static water level (feet) 150' below above top of ground.
(4) casing Plastic, 180'
(material) (depth)
4"
(size) If telescope see back.
(5) screen 5', 180'
(length) (depth to top)
4", Cravel Pack
(size) (material)
(6) pump 1, 18
(HP) (yield gpm)
Elect.
(type power)
(7) electric log
(yes or no)

(organization running log)
(8) how well bottom plugged 4"
Plastic cap

description of formations encountered	from	to
Red Clay Red Sand	0	10
White Clay	10	20
White Clay Blue Clay	20	30
Blue Clay	30	150
Blue Clay White Sand	150	160
White Sand	160	185

CODED

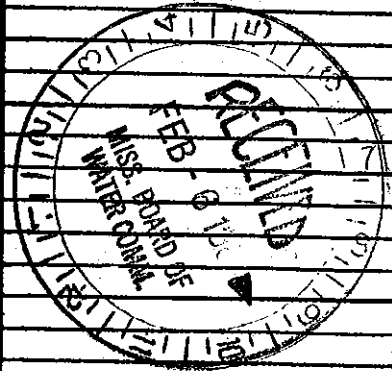

DRILLERS REMARKS: