

Benton
721
9-67

MISSISSIPPI
 BOARD OF WATER COMMISSIONERS
 416 North State Street
 Jackson, Mississippi 39201

CODED

WATER WELL DRILLERS LOG

9-5 1967 Robert Wilson Benton
 date well completed firm name county well located

LANDOWNER: Joe Beshiers
Cannon
Miss.
 (mailing address)


WELL LOCATION:
 sec. 16 T 2 N R 2 E
1 miles 5 of Brody
 (distance) (direction) (nearest town)

WELL PURPOSE:
 (home, irrigation, municipal, industrial)

WELL COMPLETION DATA:
 (1) diameter (inches) 4"
 (2) total depth (feet) 606'
 (3) static water level (feet) 40' below above top of ground
 (4) casing plastic, 586'
 (material) (depth)
4" if telescope see back.
 (size)
 (5) screen 20', 586'
 (length) (depth to top)
4" slotted pipe
 (size) (material)
 (6) pump _____ (HP) _____ (yield gpm)
Elect.
 (type power)
 (7) electric log ✓ (yes or no)
 _____ (organization running log)
 (8) how well bottom plugged 4"
plastic cap

description of formations encountered	from	to
<u>Red clay</u>	<u>0</u>	<u>20</u>
<u>White clay White sand & rock</u>	<u>20</u>	<u>40</u>
<u>Blue clay</u>	<u>40</u>	<u>57</u>
<u>Rock, Green Sand</u>	<u>57</u>	<u>57</u>
<u>Blue clay</u>	<u>57</u>	<u>58</u>
<u>Green Sand + Rock</u>	<u>58</u>	<u>606</u>

CODED

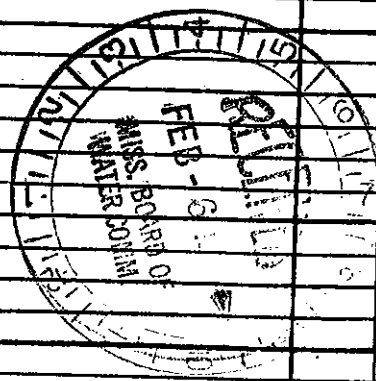

DRILLERS REMARKS: