

State Well Report Part 1 - Driller's Log

Mississippi Department of Environmental Quality
Office of Land and Water Resources
P.O. Box 10631
Jackson, MS 39289-0631
(601)961-5210
(601)354-6938 (fax)

County: Benton
 Permit #: 0-162
 Driller: Long Carpenter
 Date drilling completed: 11-30-09

For Office Use Only:

Aquifer: F 46
 Well #: _____
 L. S. Elevation: _____
 E-log #: _____

State Law requires that this report be prepared by the license holder responsible for the work and filed with the Department at the above address within 30 days of completion of drilling of the well or borehole.

Information on Well Owner <small>(Landowner if borehole is not for a water well)</small>	Well or Borehole Location
Owner Name: <u>Mario Rogostino Jr</u>	Latitude: <u>34°56'22"</u> Longitude: <u>89°07'03"</u>
Mailing Address: <u>2600 N. Reed Hooker Rd.</u>	Method of Lat/Long (circle one): Conventional Survey, _____ USGS quad, Hand-held GPS, Survey-grade GPS
City: <u>Eads</u> State: <u>Mo.</u> Zip Code: <u>38028</u>	<u>SE 1/4 NW 1/4</u> Sec <u>5</u> Twn <u>25</u> Rng <u>2E</u>
Telephone No. <u>(901) 487-6963</u>	Distance: <u>1</u> Miles Direction: <u>South</u> of Nearest Town: <u>Cameron, Mo.</u>

Well / Borehole Data

Date drilling started: 11-30-09 Date drilling completed: 11-30-09 Hole depth: 80 Hole diameter: 8"

Location of the source of any surface water used for drilling: Well Water
 Method of dosing and volume of Chlorine used in drilling and development: 1/2 pt Chlorine to 1000 Well Water

Logs run (circle all applicable): No log run Electric Gamma Ray Density Sonic Neutron Other: _____
 Name of organization running log(s): _____

Purpose of borehole (check one): Water Well Geotechnical/Geological Investigation Ground Source Heat Pump
 Seismic Survey Other (describe) _____

If drilling is not related to water well construction, skip the remainder of this block

Purpose of Well (check one): Home Industrial Public Supply Irrigation Fish Culture Other: _____

If a flowing well, method of flow regulation: Valve _____ Other (describe) _____

Static Water Level: 40 feet above or below (circle one) land surface Date measured: 11-30-09

Method of Measurement (circle one) steel tape electric tape air line other: _____

Well depth: 80 Well grouted to a depth of 10 feet Type of grout (circle one) Neat Cement Bentonite Mix

Casing length: 70 feet Casing diameter: 4 inches Type of casing: PVC

Screen length: 10 feet Screen diameter: 4 inches Type of screen: PVC

Screen slot size: .013 inches Setting depth: From 70 feet to 80 feet

Type of completion (circle all applicable): Gravel packed Underreamed Telescoped Open hole Natural Development
 Other (describe): _____

Top of lap pipe or reduction in casing: _____ feet. *If telescoped or more than one screen, describe on next page*

Form: OLWR-SWR-1A


RECEIVED
DEC 30 2009
BY: OLWR

The sketch below only required for water wells

Description of formations encountered must be provided for all wells and boreholes, unless specifically exempted by regulations **F46**

If well telescopes, show depths on sketch


Ground Level \rightarrow

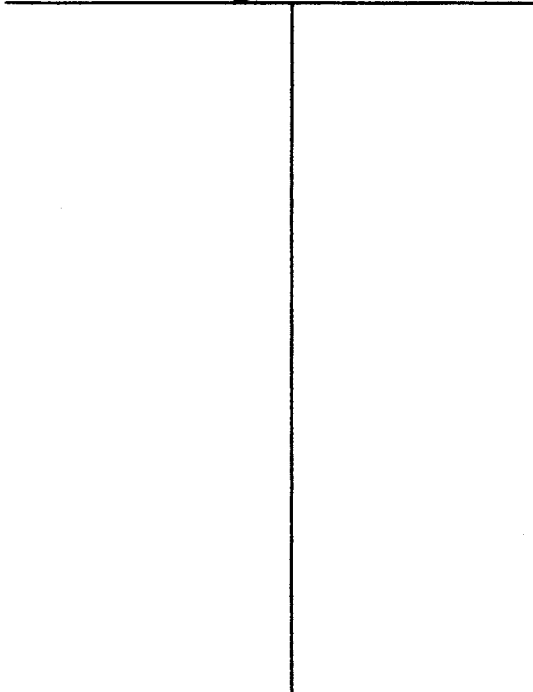

Description of Formations Encountered	From (depth)		To (depth)
	Ground Level		
Surface Sand	0		17
Med. Red Sand	17		32
White clay	32		40
White coarse Sand	40		80

If more than one screen, show location of each on sketch

Sketch the property layout and include the following: 1) the well location; 2) any permanent structures on the property that may aid in locating the well; 3) any roads, power lines, or other items that may aid in locating the property and the well; 4) a north arrow.

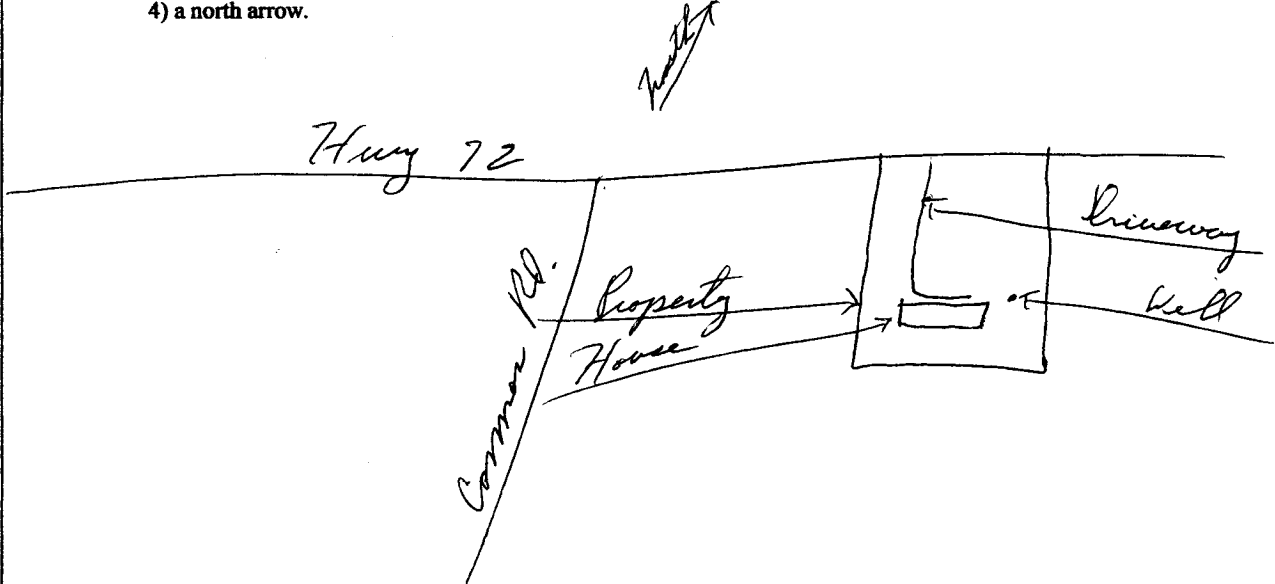

Landowner Name: Mario Dogustina Jr.

Form: OLWR-SWR-1A

I certify that the well/borehole was drilled, constructed, and completed in accordance with all applicable requirements of the Mississippi Department of Environmental Quality and the Mississippi Department of Health regulations, if applicable, and state laws.

LARRY CARPENTER - 0-162 12-6-09

Larry Carpenter

Print Name of Responsible Licensee and License No.

Date

Signature of Licensee

RECEIVED

DEC 14 2009

BY: OLWR

STATE WELL REPORT

Part 2

Pump Installer's Completion Report
 Mississippi Department of Environmental Quality
 Office of Land and Water Resources
 P.O. Box 10631
 Jackson, MS 39289-0631
 (601)961-5210
 (601)354-6938 (fax)

County: Beston
 Permit #: 0-162
 Driller: Larry Carpenter
 Date completed: 11-30-09
Copy information from block on Part 1

For Office Use Only:

Aquifer: F46
 Well #: _____
 Elevation: _____

This part of the report must be completed by a licensed water well contractor or a licensed pump installer. A copy of Part 1 of the report must be attached and both parts filed with the Department at the above address within 30 days of well completion.

Well Owner Information	Well Location
Owner Name: <u>Navio Degostes Jr.</u>	Latitude: _____ Longitude: _____
Mailing Address: <u>2600 N Reed Hooker Rd.</u>	Method of Lat/Long (check one): Conventional Survey _____
<u>Esda</u> <u>Jr.</u> <u>38028</u>	USGS quad _____, Hand-held GPS _____, Survey-grade GPS _____
City State Zip Code	_____ 1/4 _____ 1/4 Sec <u>5</u> T <u>25</u> R <u>2E</u>
Telephone No. <u>(901) 487-6963</u>	Distance Direction Nearest Town
	<u>1</u> Miles <u>South</u> of <u>Corner</u>

Pump Type Circle one	Power Type Circle one
Air Lift Jet <input checked="" type="radio"/> Submersible	Diesel Engine Gasoline Engine Natural Gas
Bucket Piston Turbine	<input checked="" type="radio"/> Electric Motor Hand Tractor PTO
Centrifugal Rotary Flowing Well	Windmill Other (specify): _____
Other (specify): _____	Horse Power Rating of Motor: <u>3/4</u>
Date Pump Installed: <u>11-30-09</u>	Setting Depth: <u>60</u> feet
Rated Pump Capacity: <u>12</u> Gallons Per Minute	Number of Stages: <u>11</u>

Pump Test Data	Method of Measuring Water Level Circle one
Date Well Tested: <u>11-30-09</u>	Air Line Electric Measuring Line <input checked="" type="radio"/> Steel Tape
Static Water Level (A): <u>40</u> Feet Below Land Surface	Other (specify): _____
Pumping Water Level (B): <u>48</u> Feet Below Land Surface	For flowing well, measured shut in head: _____ feet
Drawdown [(B) - (A)]: <u>8</u> Feet Below Land Surface	Well yielded <u>20</u> GPM with a drawdown of
Test Pumping Rate: <u>20</u> Gallons Per Minute	<u>8</u> feet after <u>4</u> hours of pumping
Duration of Pump Test (minimum 4 hours): <u>4</u> hours	

I HEREBY CERTIFY that the above statements are true to the best of my knowledge.

LARRY CARPENTER 0-162 Larry Carpenter
 Print Name of Pump Installer and License No. (if applicable) Signature of Pump Installer

RECEIVED
 Form: OLWR SWR 18
 DEC 30 2009
 BY: OLWR