

**State Well Report
Part 1 - Driller's Log**

Mississippi Department of Environmental Quality
Office of Land and Water Resources
P.O. Box 10631
Jackson, MS 39289-0631
(601)961-5210
(601)354-6938 (fax)

For Office Use Only:

Aquifer: _____
Well #: F47
L. S. Elevation: _____
E-log #: _____

County: Benton
Permit #: 0-162
Driller: Larry Carpenter
Date drilling completed: 3-27-13

State Law requires that this report be prepared by the license holder responsible for the work and filed with the Department at the above address within 30 days of completion of drilling of the well or borehole.

Information on Well Owner (Landowner if borehole is not for a water well)	Well or Borehole Location
Owner Name: <u>Robert S. Culifer</u>	Latitude: <u>34° 58' 12"</u> Longitude: <u>89° 21' 59"</u>
Mailing Address: <u>5193 Old Hwy 79</u>	Method of Lat/Long (circle one): <u>Hand-held GPS</u> Conventional Survey, <u>OS</u> <u>SS</u>
<u>Ashland MS 38603</u>	USGS quad, <u>Hand-held GPS</u> Survey-grade GPS
City State Zip Code	<u>SE NW</u> Sec <u>7A</u> Twn <u>25</u> Rng <u>2E</u>
Telephone No. <u>(662) 224 4680</u>	Distance Direction Nearest Town <u>1 1/2</u> Miles <u>East</u> of <u>Canaan</u>

Well / Borehole Data

Date drilling started: 3-27-13 Date drilling completed: 3-27-13 Hole depth: 192' Hole diameter: 8"

Location of the source of any surface water used for drilling: Well Water

Method of dosing and volume of Chlorine used in drilling and development: 1/2 gal Chlorine to 1000 Gal. Water

Logs run (circle all applicable): No log run Electric Gamma Ray Density Sonic Neutron Other: _____

Name of organization running log(s): _____

Purpose of borehole (check one): Water Well Geotechnical/Geological Investigation ___ Ground Source Heat Pump ___

Seismic Survey ___ Other (describe) _____

If drilling is not related to water well construction, skip the remainder of this block

Purpose of Well (check one): Home Industrial ___ Public Supply ___ Irrigation ___ Fish Culture ___ Other: _____

If a flowing well, method of flow regulation: Valve ___ Other (describe) _____

Static Water Level: 2.5 feet above or below (circle one) land surface Date measured: 3-27-13

Method of Measurement (circle one) steel tape electric tape air line other: _____

Well depth: 192' Well grouted to a depth of 10 feet Type of grout (circle one): Neat Cement Bentonite Mix

Casing length: 172 feet Casing diameter: 4 inches Type of casing: PVC

Screen length: 20 feet Screen diameter: 4 inches Type of screen: PVC

Screen slot size: .013 inches Setting depth: From 172 feet to 192 feet

Type of completion (circle all applicable): Gravel packed Underreamed Telescoped Open hole Natural Development

Other (describe): _____

Top of lap pipe or reduction in casing: _____ feet. *If telescoped or more than one screen, describe on next page*

RECEIVED
Form: OLWR-SWR-1A


APR 25 2013

BY: OLWR

The sketch below only required for water wells

Description of formations encountered must be provided for all wells and boreholes, unless specifically exempted by regulations


If well telescopes, show depths on sketch.

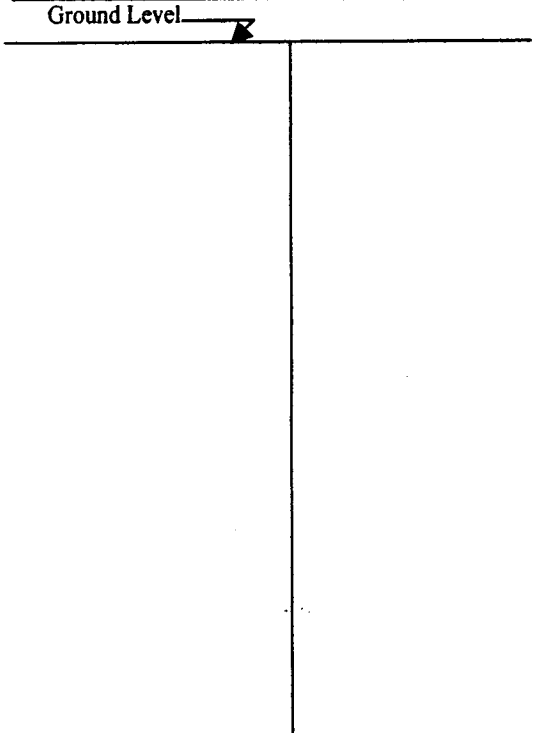

Description of Formations Encountered	From (depth)	To (depth)
	Ground Level	
Surface Soil	0	18
med. Red Sand	18	40
Fine White Sand	40	75
White clay	75	88
Blue clay	88	130
med. Gray Sand.	130	192

If more than one screen, show location of each on sketch

Sketch the property layout and include the following: 1) the well location; 2) any permanent structures on the property that may aid in locating the well; 3) any roads, power lines, or other items that may aid in locating the property and the well; 4) a north arrow.

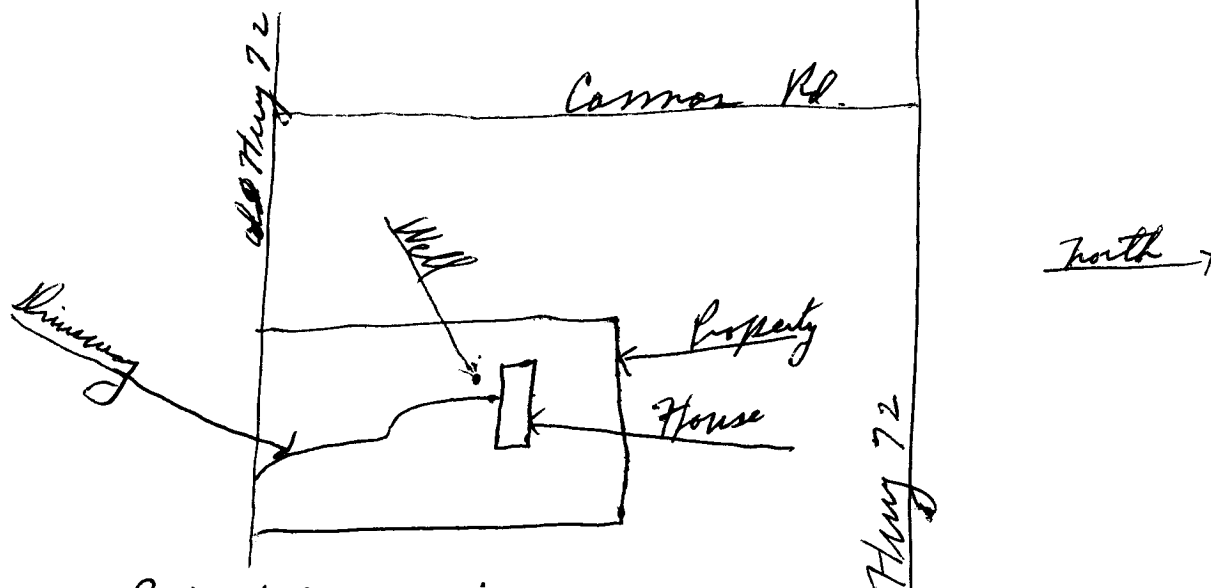

Landowner Name: Robert S. Culifer

Form: OLWR-SWR-1A

I certify that the well/borehole was drilled, constructed, and completed in accordance with all applicable requirements of the Mississippi Department of Environmental Quality and the Mississippi Department of Health regulations, if applicable, and state laws.

Garry Carpenter #0-162 4-5-13
 Print Name of Responsible Licensee and License No. Date

Garry Carpenter
 Signature of Licensee

RECEIVED
 APR 25 2013

BY: OLWR

STATE WELL REPORT

Part 2

Pump Installer's Completion Report
 Mississippi Department of Environmental Quality
 Office of Land and Water Resources
 P.O. Box 10631
 Jackson, MS 39289-0631
 (601)961-5210
 (601)354-6938 (fax)

County: Benton
 Permit #: 0-162
 Driller: Larry Carpenter
 Date completed: 3-27-13
Copy information from block on Part 1

For Office Use Only:

Aquifer: _____
 Well #: F47
 Elevation: _____

This part of the report must be completed by a licensed water well contractor or a licensed pump installer. A copy of Part 1 of the report must be attached and both parts filed with the Department at the above address within 30 days of well completion.

Well Owner Information	Well Location
Owner Name: <u>Robert S Culefer</u>	Latitude: <u>34° 58.139</u> Longitude: <u>89° 27.539</u>
Mailing Address: <u>5193 Old Hwy 72</u>	Method of Lat/Long (check one): Conventional Survey _____
<u>Oakland ms 38603</u>	USGS quad _____ Hand-held GPS <input checked="" type="checkbox"/> Survey-grade GPS _____
City State Zip Code	_____ 1/4 _____ 1/4 Sec <u>72</u> T <u>25</u> R <u>2E</u>
Telephone No. <u>(662) 224 4680</u>	Distance Direction Nearest Town
	<u>1 1/2</u> Miles <u>East</u> of <u>Carman</u>

Pump Type Circle one	Power Type Circle one
Air Lift Jet <input checked="" type="radio"/> <u>Submersible</u>	Diesel Engine Gasoline Engine Natural Gas
Bucket Piston Turbine	<input checked="" type="radio"/> <u>Electric Motor</u> Hand Tractor PTO
Centrifugal Rotary Flowing Well	Windmill Other (specify): _____
Other (specify): _____	Horse Power Rating of Motor: <u>3/4</u>
Date Pump Installed: <u>3-27-13</u>	Setting Depth: <u>60</u> feet
Rated Pump Capacity: <u>12</u> Gallons Per Minute	Number of Stages: <u>11</u>

Pump Test Data	Method of Measuring Water Level Circle one
Date Well Tested: <u>3-27-13</u>	Air Line Electric Measuring Line <input checked="" type="radio"/> <u>Steel Tape</u>
Static Water Level (A): <u>25</u> Feet Below Land Surface	Other (specify): _____
Pumping Water Level (B): <u>32</u> Feet Below Land Surface	For flowing well, measured shut in head: _____ feet
Drawdown [(B) - (A)]: <u>7</u> Feet Below Land Surface	Well yielded <u>15</u> GPM with a drawdown of
Test Pumping Rate: <u>15</u> Gallons Per Minute	<u>7</u> feet after <u>4</u> hours of pumping
Duration of Pump Test (minimum 4 hours): <u>4</u> hours	

I HEREBY CERTIFY that the above statements are true to the best of my knowledge.

Larry Carpenter # 0-162 **RECEIVED**
 Print Name of Pump Installer and License No. (if applicable) Larry Carpenter
 Signature of Pump Installer APR 25 2013

Form: OLWR-SWR-18
 BY: OLWR