

BENTON MISSISSIPPI BOARD OF WATER COMMISSIONERS

F 2002


WATER WELL DRILLERS LOG

8-63

Date: Aug, 1963, Driller: Robert W. Wilson County Benton

(Name)

(1) Owner of Land: <u>W.A. Mauldin</u> (Name)	Description & Color of Materials Sand, Clay, Red Clay, Shell, etc.	Thick- ness Feet	Depth Feet
<u>Faulkner</u> (Address)	<u>Clay + Red Sand mixed</u>	<u>50</u>	<u>0-50</u>
(2) Location: <u>1/4</u> , <u>1/4</u> , Sec. <u>T</u> <u>R</u>	<u>White sand</u>	<u>20</u>	<u>50-70</u>
<u>5</u> miles <u>NW</u> of <u>Faulkner</u> (distance) (direction) (Nearest Town)	<u>" + clay</u>	<u>25</u>	<u>70-95</u>
(3) Topography: _____ (Hilly) (Flat) (Level)			
(4) Purpose of Well: <u>Home</u> (Domestic Irrigation Municipal, Industrial, Other)			
Information upon completion of well:			
(1) Diameter <u>4</u> inches.			
(2) Total Depth <u>95</u> feet.			
(3) Water Level <u>84</u> feet below top of ground.			
(4) Cased to <u>95</u> , Size <u>4</u>			
(5) Screen: Size <u>4</u> , Length <u>6</u>			
(6) Were any formations sealed against pollution?			
_____ yes, <u>X</u> no.			
If YES depth of formation _____			
Why _____			
Drillers Remarks: _____			

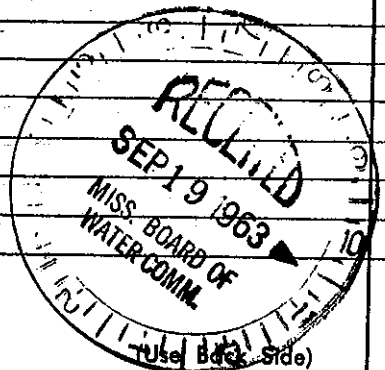

Well No.

Mail this copy to Board of Water Commissioners 429 Miss. St. Jackson, Miss!