


**BENTON** MISSISSIPPI BOARD OF WATER COMMISSIONERS

F 2004  
9-15-64

**WATER WELL DRILLERS LOG**

Date: Sept 15, 1964, Driller: Robert W. Wilson County Benton  
(Name)

	Description & Color of Materials Sand, Clay, Red Clay, Shell, etc.	Thick- ness Feet	Depth Feet
(1) Owner of Land: <u>Tom Green</u> (Name)	Red dirt	10	10
<u>Ashland, Miss</u> (Address)	" sand	70	80
(2) Location: <u>1/4</u> , <u>1/4</u> , Sec. <u>T</u> <u>R</u>	" " + clay	10	90
<u>1/2</u> miles <u>S</u> , of <u>Canaan</u> (distance) (direction) (Nearest Town)	white sand	48	138
(3) Topography: <u>X</u> (Hilly) (Flat) (Level)			
(4) Purpose of Well: <u>Domestic</u> (Domestic Irrigation Municipal, Industrial, Other)			
Information upon completion of well:			
(1) Diameter <u>4</u> inches.			
(2) Total Depth <u>138</u> feet.			
(3) Water Level <u>90</u> feet below top of ground.			
(4) Cased to <u>138</u> , Size <u>4"</u>			
(5) Screen: Size <u>4</u> , Length <u>6</u>			
(6) Were any formations sealed against pollution? <u>no</u>			
If YES depth of formation _____			
Why _____			
Drillers Remarks: _____			
_____			
_____			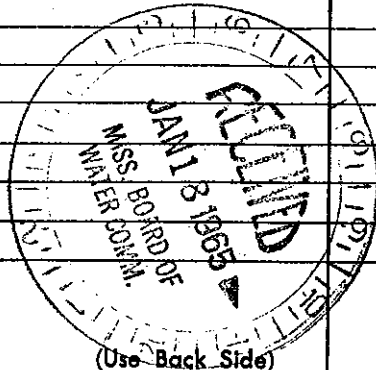
Well No.

Mail this copy to Board of Water Commissioners 429 Miss. St. Jackson, Miss.