

BENTON MISSISSIPPI BOARD OF WATER COMMISSIONERS

F 2006

9-16-64


WATER WELL DRILLERS LOG

Robert Wilson

Date: Sept. 16, 1964, Driller: Elizabeth McClellar County Benton

(Name)

(1) Owner of Land: <u>Elizabeth McClellar</u> (Name)	Description & Color of Materials Sand, Clay, Red Clay, Shell, etc.	Thick- ness Feet	Depth Feet
<u>Ashland, Miss</u> (Address)	<u>Red dirt</u>	<u>10</u>	<u>10</u>
(2) Location: <u>1/4</u> , <u>1/4</u> , Sec. <u>T</u> <u>R</u>	<u>" sand</u>	<u>70</u>	<u>80</u>
<u>1/2</u> miles <u>W</u> , of <u>Canaan</u> (distance) (direction) (Nearest Town)	<u>white "</u>	<u>43</u>	<u>123</u>
(3) Topography: <u>f</u> (Hilly) (Flat) (Level)			
(4) Purpose of Well: <u>Domestic</u> (Domestic Irrigation Municipal, Industrial, Other)			
Information upon completion of well:			
(1) Diameter <u>4</u> inches.			
(2) Total Depth <u>122</u> feet.			
(3) Water Level <u>90</u> feet below top of ground.			
(4) Cased to <u>122</u> , Size <u>4</u>			
(5) Screen: Size <u>4</u> , Length <u>4</u>			
(6) Were any formations sealed against pollution?			
<u>yes</u> , <u>1</u> no.			
If YES depth of formation _____			
Why _____			
Drillers Remarks: _____			

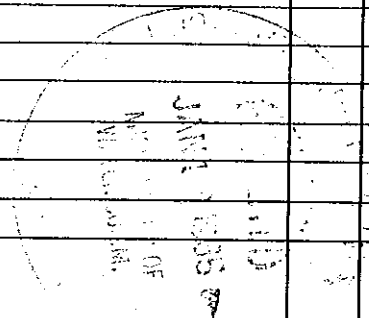

(Use Back Side)

Well No.

Mail this copy to Board of Water Commissioners 429 Miss. St. Jackson, Miss.