

BENTON
F 2026
1/23/81
Jan 23, 1981

MISSISSIPPI
BOARD OF WATER COMMISSIONERS
416 North State Street
Jackson, Mississippi 39201

WATER WELL DRILLERS LOG

date well completed 1981 R.L. Carpenter Benton
firm name county well located


LANDOWNER: William Wilburn
Oakland, Miss
RFD
(mailing address)

WELL LOCATION:
sec. 10 T. 2 N. R. 2 E
3 miles East of Corona
(distance) (direction) (nearest town)

WELL PURPOSE: none
(home, irrigation, municipal, industrial)

WELL COMPLETION DATA:
(1) diameter (inches) 4
(2) total depth (feet) 247
(3) static water level (feet) 98 below above top of ground.
(4) casing PVC 227'
(material) (depth)
(size) if telescope see back.
(5) screen 20' 227'
(length) (depth to top)
4" PVC
(size) (material)
(6) pump 3/4 12
(HP) (yield gpm)
Elco
(type power)
(7) electric log No
(yes or no)
(organization running log)
(8) how well bottom plugged PVC cap

description of formations encountered	from	to
Surface Soil	0	18
Red Red Soil	18	28
Rock	28	29
White clay	29	50
Blue mud	50	205
Fine Gray Sand	205	218
Med Gray & White Sand	218	247

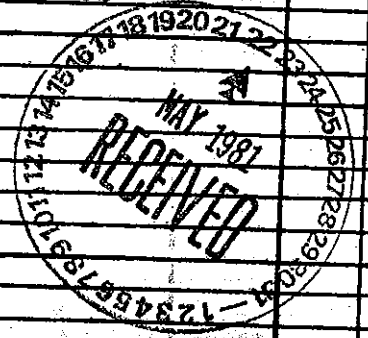

DRILLERS REMARKS: