

Benton
G 10
5-66

MISSISSIPPI
BOARD OF WATER COMMISSIONERS
416 North State Street
Jackson, Mississippi 39201

CODED

WATER WELL DRILLERS LOG

5-5 1966 Robert M. Wilson Benton
date well completed firm name county well located

LANDOWNER: Emory White
Ashland
Miss.
(mailing address)


WELL LOCATION:
sec. 10 T 3 N R 1 E
1 1/2 miles NW of Ashland
(distance) (direction) (nearest town)

WELL PURPOSE: home
(home, irrigation, municipal, industrial)

- WELL COMPLETION DATA:
- (1) diameter (inches) 4"
 - (2) total depth (feet) 178'
 - (3) static water level (feet) 148' below top of ground.
 - (4) casing Plastic 174' (material) (depth)
4" (size) If telescope see back.
 - (5) screen 4' 174' (length) (depth to top)
209au (size) (material)
 - (6) pump 3/4 (HP) (yield gpm)
Elect. (type power)
 - (7) electric log NO (yes or no)
(organization running log)
 - (8) how well bottom plugged 4"
plastic cap

description of formations encountered	from	to
Red Dirt	0	10
Red Sand	10	40
Red Sand + clay	40	50
white clay + Sand	50	80
white Sand	80	110
white Sand + clay	110	130
white Sand	130	178

CODED

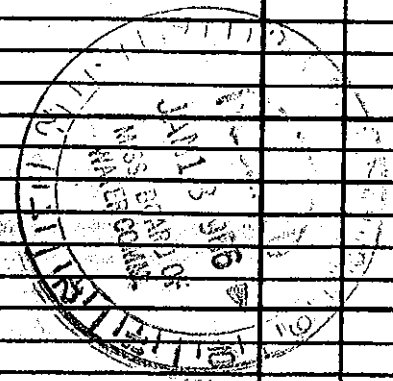

DRILLERS REMARKS: