

Benton
G11
6-66

MISSISSIPPI
BOARD OF WATER COMMISSIONERS
416 North State Street
Jackson, Mississippi 39201

CODED

WATER WELL DRILLERS LOG

6-21 1966 Robert M. Wilson Benton
date well completed firm name county well located

LANDOWNER: Sam White
Lamar
Miss
(mailing address)


WELL LOCATION:
sec. 3 T. 3 N R. 1 E
5 miles SE of Lamar
(distance) (direction) (nearest town)

WELL PURPOSE: home
(home, irrigation, municipal, industrial)

WELL COMPLETION DATA:
(1) diameter (inches) 4"
(2) total depth (feet) 150'
(3) static water level (feet) 130' below top of ground.
(4) casing Plastic 146'
(material) (depth)
4" (size) If telescope see back.
(5) screen 4' 146"
2092 (length) (depth to top)
4" (size) Bul. Pac Slotted Pipe (material)
(6) pump 3/4 (HP) (yield gpm)
Elect. (type power)
(7) electric log NO (yes or no)
(organization running log)
(8) how well bottom plugged 4"
Plastic cap

description of formations encountered	from	to
Red dirt	0	20
Red sand	20	30
Red sand & clay	30	50
White clay & sand	50	60
White sand	60	100
White clay	100	110
White clay & sand	110	130
White sand	130	150

CODED

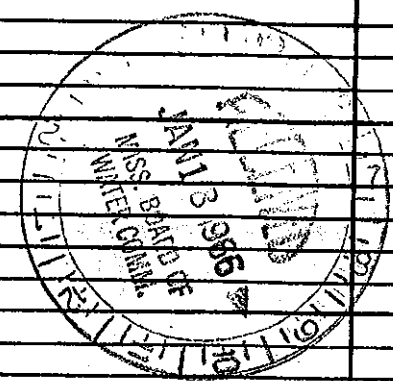

DRILLERS REMARKS: