

State Well Report

Part 1

Mississippi Department of Environmental Quality
Office of Land and Water Resources
P.O. Box 10631
Jackson, MS 39289-0631
(601)961-5210
(601)354-6938 (fax)

For Office Use Only:

Aquifer: _____
Well #: G-30
L. S. Elevation: _____
E-log #: _____

County: Benton
Permit #: _____
Driller: Wilson Well
Date drilling completed: 9-2-05

State Law requires that this report be prepared by the driller in detail and filed with the Department within 30 days of completion of drilling of the well.

Well Owner Information	Well Location
Owner Name: <u>TOM DEHART</u>	Latitude: _____° _____' _____" Longitude: _____° _____' _____"
Mailing Address: <u>McGAUGHY ROAD</u>	Method of Lat/Long (circle one): Conventional Survey, USGS quad, Hand-held GPS, Survey-grade GPS
<u>ASHLAND</u> <u>AR</u> City State Zip Code	_____ 1/4 _____ 1/4 Sec <u>36</u> Twn <u>T3S</u> Rng <u>R1W</u>
Telephone No. <u>(901) 755-8416</u>	Distance <u>3</u> Miles Direction <u>South</u> of Nearest Town <u>Highway 4</u>

Well Data

Purpose of Well (circle one) Home Industrial Public Supply Irrigation Fish Culture Other: _____

Date well drilling started: 9-2-05 Date well drilling completed: 9-2-05

If flowing, method of flow regulation: Valve _____ Other (describe) _____

Static Water Level: 14 feet above or below (circle one) land surface Date measured: 9-2-05

Method of Measurement (circle one) steel tape electric tape air line other: Pvc Pvc

Hole depth: 62 Well depth: 62 Well grouted to a depth of 10 feet

Type of grout (circle one): Cement Bentonite Mix

Casing length: 52 feet Casing diameter: 4 inches Type of casing: Plastic PVC

Screen length: 10 feet Screen diameter: 4 inches Type of screen: Plastic PVC

Screen slot size: .010 inches Setting depth: From 52 feet to 62 feet

Type of completion (circle all applicable): Gravel packed Underreamed Telescoped Open hole Natural Development
Other (describe): _____

Top of lap pipe or reduction in casing: NA feet. If telescoped or more than one screen, describe on back of page

Logs run (circle all applicable) No log run Electric Gamma Ray Density Sonic Neutron Other: _____

Name of organization running log(s): _____

RECEIVED
SEP 30 2005
BY: OLWR

I certify that the well was drilled, constructed, and completed in accordance with all applicable requirements of the Mississippi Department of Environmental Quality and/or the Mississippi Department of Health regulations and state laws.

Rodney D. Wilson 0-418 _____
Print Name of Water Well Contractor and License No. Signature of Water Well Contractor

If well telescopes please sketch below and show depths.

6-30

Ground Level


Description of Formations Encountered

From To

Description of Formations Encountered	From	To

If more than one screen, show location of each on sketch

Sketch the property layout and include the following: 1) the well location; 2) any permanent structures on the property that may aid in locating the well; 3) any roads, power lines, or other items that may aid in locating the property and the well; 4) indicate direction.

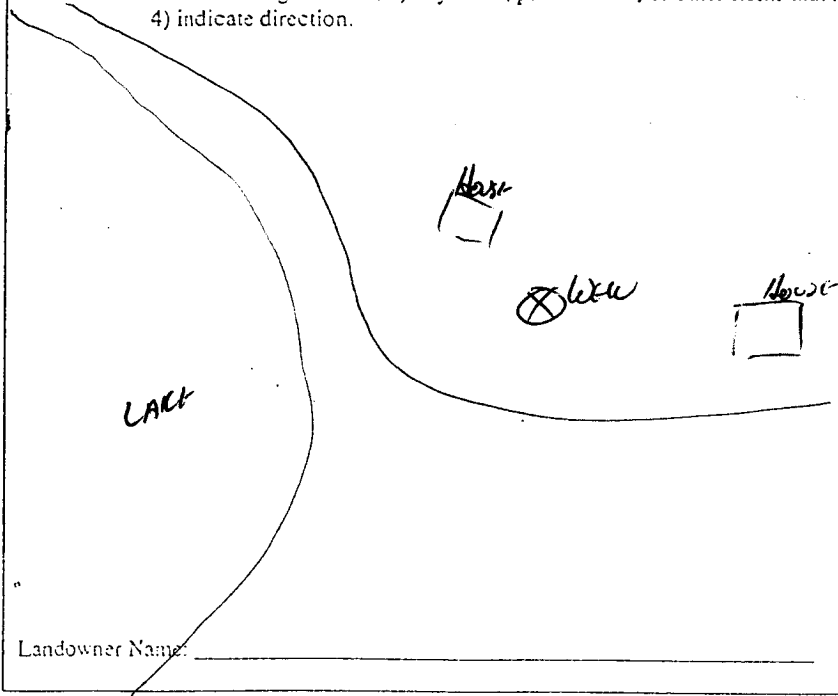

RECEIVED
SEP 30 2005
BY: OLWR

R. J. Hill
Signature of Water Well Contractor

STATE WELL REPORT

Part 2

Pump Installer's Completion Report
 Mississippi Department of Environmental Quality
 Office of Land and Water Resources
 P.O. Box 10631
 Jackson, MS 39289-0631
 (601)961-5210
 (601)354-6938 (fax)

County: Benton
 Permit #: _____
 Driller: Wilson Well Co.
 Date completed: 9-2-05
Copy information from block on Part 1

For Office Use Only:

Aquifer: _____
 Well #: 6-30
 Elevation: _____

This part of the report must be completed by a licensed water well contractor or a licensed pump installer. A copy of Part 1 of the report must be attached and both parts filed with the Department at the above address within 30 days of well completion.

Well Owner Information	Well Location
Owner Name: <u>TOM KEHANT</u>	Latitude: _____ Longitude: _____
Mailing Address: <u>163 CAWNEY LANE</u>	Method of Lat/Long (check one): Conventional Survey _____
<u>ASHLAN</u> <u>MS.</u>	USGS quad _____, Hand-held GPS _____, Survey-grade GPS _____
City State Zip Code	_____ 1/4 _____ 1/4 Sec <u>36</u> T <u>35</u> R <u>1W</u>
Telephone No. <u>(801) 755-8416</u>	Distance Direction Nearest Town
	<u>3</u> Miles <u>SOUTH</u> of <u>HWY 4</u>

Pump Type Circle one	Power Type Circle one
Air Lift Jet <input checked="" type="radio"/> <u>Submersible</u>	Diesel Engine Gasoline Engine Natural Gas
Bucket Piston Turbine	<input checked="" type="radio"/> <u>Electric Motor</u> Hand Tractor PTO
Centrifugal Rotary Flowing Well	Windmill Other (specify): _____
Other (specify): _____	Horse Power Rating of Motor: <u>1 1/2</u>
Date Pump Installed: <u>9-2-05</u>	Setting Depth: <u>42</u> feet
Rated Pump Capacity: <u>10</u> Gallons Per Minute	Number of Stages: <u>4</u>

RECEIVED
 SEP 30 2005
 BY: OLWR

Pump Test Data	Method of Measuring Water Level Circle one
Date Well Tested: <u>9-2-05</u>	Air Line Electric Measuring Line Steel Tape
Static Water Level (A): <u>14</u> Feet Below Land Surface	Other (specify): <u>PVC PIPE</u>
Pumping Water Level (B): <u>58</u> Feet Below Land Surface	For flowing well, measured shut in head: _____ feet
Drawdown [(B) - (A)]: _____ Feet Below Land Surface	Well yielded _____ GPM with a drawdown of _____ feet after _____ hours of pumping
Test Pumping Rate: <u>22</u> Gallons Per Minute	
Duration of Pump Test (minimum 4 hours): _____ hours	

I HEREBY CERTIFY that the above statements are true to the best of my knowledge.

Rocky D. Wells 0-418 Rocky D. Wells
 Print Name of Pump Installer and License No. (if applicable) Signature of Pump Installer