


**BENTON** MISSISSIPPI BOARD OF WATER COMMISSIONERS

**G** 2000

**10-13-64** WATER WELL DRILLERS LOG

Date: Oct. 13, 1964, Driller: Robert W. Wilson County Benton  
(Name)

(1) Owner of Land: <u>Mrs. Clay Crawford</u> <small>(Name)</small>	Description & Color of Materials Sand, Clay, Red Clay, Shell, etc.	Thick- ness Feet	Depth Feet
<u>Holly Springs</u> <small>(Address)</small>	<u>Red Sand</u>	<u>120</u>	<u>120</u>
(2) Location: <u>1/4</u> , <u>1/4</u> , Sec. <u>T. R.</u>	<u>White clay-white sand</u>	<u>10</u>	<u>130</u>
<u>3</u> miles <u>NW</u> , of <u>Shores</u> <small>(distance) (direction) (Nearest Town)</small>	<u>" sand (some clay)</u>	<u>40</u>	<u>170</u>
(3) Topography: <u>A</u> <small>(Hilly) (Flat) (Level)</small>			
(4) Purpose of Well: <u>Domestic</u> <small>(Domestic Irrigation Municipal, Industrial, Other)</small>			
Information upon completion of well:			
(1) Diameter <u>4</u> inches.			
(2) Total Depth <u>170</u> feet.			
(3) Water Level <u>130</u> feet below top of ground.			
(4) Cased to <u>170</u> , Size <u>4</u>			
(5) Screen: Size <u>4</u> , Length <u>4</u>			
(6) Were any formations sealed against pollution?			
<u>no</u>			
If YES depth of formation			
Why			
Drillers Remarks:			

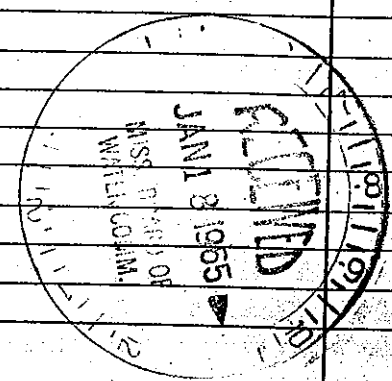

Well No.

(Use Back Side)

Mail this copy to Board of Water Commissioners 429 Miss. St. Jackson, Miss