

BENTON  
9 2002  
10-8-75

MISSISSIPPI  
 BOARD OF WATER COMMISSIONERS  
 416 North State Street  
 Jackson, Mississippi 39201

WATER WELL DRILLERS LOG

10-8- 1975 Robert W. Wilson Benton  
 date well completed firm name county well located

LANDOWNER: Eddie Peterson  
Holly Springs, Miss.  
 (mailing address)


WELL LOCATION:  
 sec. 3 T. 3 N. R. 1 E.  
 (distance) miles (direction) of (nearest town)

WELL PURPOSE:  
 (home irrigation, municipal, industrial)

- WELL COMPLETION DATA:
- (1) diameter (inches) 4
  - (2) total depth (feet) 163
  - (3) static water level (feet) 125 <sup>below</sup> ~~above~~ top of ground.
  - (4) casing galv (material), (depth),  
4 (size) if telescope see back.
  - (5) screen 4 (length), 159 (depth to top),  
4 (size), gravel packed (material)
  - (6) pump 3/4 (HP), 10 (yield gpm),  
electric (type power)
  - (7) electric log (yes or no)
  - (organization running log)
  - (8) how well bottom plugged 4"  
plastic cap

description of formations encountered	from	to
<u>Red. clay &amp; Red Sand</u>	<u>0</u>	<u>15</u>
<u>white sand</u>	<u>15</u>	<u>40</u>
<u>white sand &amp; white clay</u>	<u>40</u>	<u>60</u>
<u>white sand</u>	<u>60</u>	<u>98</u>
<u>white clay</u>	<u>98</u>	<u>105</u>
<u>white sand</u>	<u>105</u>	<u>163</u>

DRILLERS REMARKS:

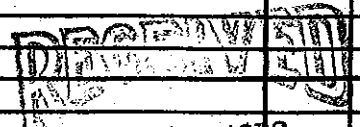

MAY 13 1976