

MISSISSIPPI DEPARTMENT OF NATURAL RESOURCES


Bureau of Land and Water Resources

Southport Mall

P.O. Box 10631

Jackson, Mississippi 39209

WATER WELL DRILLERS LOG

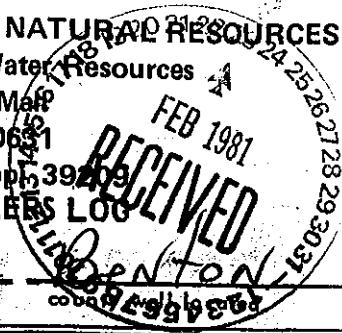

BENTON  
G 7021

2/13/87  
2-13-81  
date well completed

Wilson Well Co, Inc  
firm name

LANDOWNER:  
Leroy Sprayberry  
Rt 2  
Ashland, Miss  
(mailing address)

description of formations encountered	from	to
<u>Red Clay Red Sand</u>	<u>0</u>	<u>30</u>
<u>Red Sand</u>	<u>30</u>	<u>60</u>
<u>Red Sand</u>	<u>60</u>	<u>90</u>
<u>White Clay White Sand</u>	<u>90</u>	<u>105</u>
<u>White Sand</u>	<u>105</u>	<u>150</u>

WELL LOCATION:  
sec. 5 T. 3 N. R. 1 E.  
4 miles NW of Ashland  
(distance) (direction) (nearest town)

WELL PURPOSE: home  
(home, irrigation, municipal, industrial)

- WELL COMPLETION DATA:
- (1) diameter (inches) 4
  - (2) total depth (feet) 145
  - (3) static water level (feet) 105 below above top of ground.
  - (4) casing Plastic, 135  
(material) (depth)  
4 if telescope see back.  
(size)
  - (5) screen 10' 145  
(length) (depth to top)  
4, Plastic  
(size) (material)
  - (6) pump 1 15  
(HP) (yield gpm)  
electric  
(type power)
  - (7) electric log No  
(yes or no)  
  
(organization running log)
  - (8) how well bottom plugged 4  
Plastic Cap

DRILLERS REMARKS:

