

Benton
H24
9-66

MISSISSIPPI
BOARD OF WATER COMMISSIONERS
416 North State Street
Jackson, Mississippi 39201

CODED

WATER WELL DRILLERS LOG

9-6 1966 Robert W. Wilson Benton
date well completed firm name county well located


LANDOWNER: Murray Huddleston Ashland Miss. (mailing address)	description of formations encountered	from	to
	Red dirt	0	10
	Red sand	10	50
	White sand	50	140

WELL LOCATION:
sec. 2 T. 3 N. R. 1 E.
1 miles N of Ashland
(distance) (direction) (nearest town)

WELL PURPOSE: home
(home, irrigation, municipal, industrial)

- WELL COMPLETION DATA:
- (1) diameter (inches) 4"
 - (2) total depth (feet) 140'
 - (3) static water level (feet) 100' below top of ground.
 - (4) casing Plastic, 136' (material) (depth)
4" (size) if telescope see back.
 - (5) screen 4' 136' (length) (depth to top)
20 gpm (size) Gal. per Stotted Pipe (material)
 - (6) pump 1/2 (HP) (yield gpm)
Elect. (type power)
 - (7) electric log NO (yes or no)
(organization running log)
 - (8) how well bottom plugged 4"
plastic cap

CODED

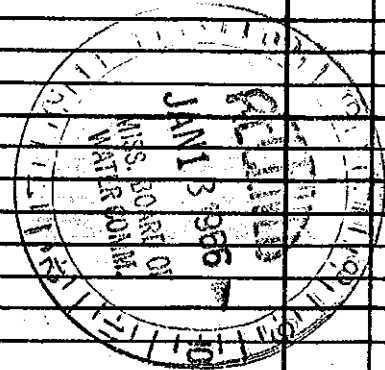

DRILLERS REMARKS: